

CERTIFIED RECORD OF LAND CORNER MONUMENTATION

INDEX No. E-5
 History of original corner establishment:

Corner originally established in 1881, by Edward W. Sanderson, under General Land Office Contract No. 417. Surveyor General's Notes State: (See official GLO Notes)

DIAGRAM	
T59 R28E	---
S41S5	---
S71S8	---
1938	---
GLO	---

In 1938 Leonard Carter, Cadastral Engineer for the "General Land Office" performed a Dependent Resurvey, Those Notes State: Proportional measure set an iron post, 3 ft. long, 2 ins. diam., 28 ins. in the ground, for cor. secs. 5,6,7, and 8, with brass cap mkd. (see DIAGRAM), from which

A Douglas fir, 24 ins. diam., bears N22-1/2°E., 160 lks. dist. mkd. T59 R28E S587
 A yellow pine, 40 ins. diam., bears S43-1/2°E., 196 lks. dist. mkd. T59 R28E S987
 A Douglas fir, 20 ins. diam., bears S73-1/2°W., 156 lks. dist. mkd. T59 R28E S757
 A Douglas fir, 25 ins. diam., bears N78°W., 30 lks. dist. mkd. T59 R28E S687
 Raised a mound of stone, 3 ft. base, 3 ft. high, W. of cor.

Found a 2" galv. iron pipe with 2-1/2" brass cap monument, stamped as shown on the **DIAGRAM**, set in a ring of stone.

From which:

- Found a Fir 36" dia., live in good condition, Bears N78°W., 19.8 ft.
- Found a Fir snag, 24" dia., Bears N22-1/2°E., 105.6 ft.
- Found a Pine, 41" dia., live in good condition, Bears S43-1/2°E., 129.4 ft.
- Found a Fir 32" dia., live in good condition, Bears, S73-1/2°W., 103.0 ft.

Description of monument and accessories | established to perpetuate the original location of this corner:


Maintained Corner by setting a steel fence post with warning sign 5 ft. East from the corner

From which.

Maintained Accessories by painting a 6" red band around all bearing trees and nailing bearing tree and warning signs to all bearing trees. (old & new) Scribed a new bearing tree:

A Fir 20" dia. Bears, N 5E., 83.3 ft., scribed: T59 R28E S5 BT

Also nailed a Brass washer stamped "PLS 848 SURVEY MARKER" to new Bearing Tree Measurements to trees taken with a metal tape and magnetic compass, with Declination set off 20 deg. East.

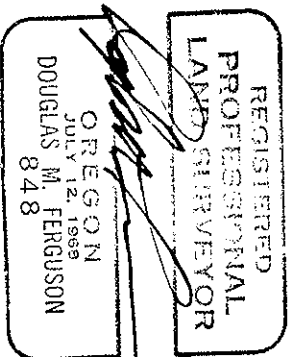

RECEIVED BY
 Morrow County Surveyor
 1-10-86
 MLD
 730-K

Work by D.M. Ferguson, PLS 848, Mt. Vernon Ore.
 On Aug. 7, 1984
 Witnessed by J. David Brinton, PLS 2065

Office of SURVEYOR County of MOSSBOW
 State of OREGON I hereby certify that the within instrument was filed in this office
 for record on the 10th day of SEPTEMBER, 1985
David H. Krumbein by Brent Reynolds
 (COUNTY OFFICIAL) (DEPUTY)