

CERTIFIED RECORD OF LAND CORNER MONUMENTATION

INDEX No. E-6

History of original corner establishment:

Corner not previously established.

DIAGRAM	
TSS R28E	
SS	
W1/16-.	
SS	
1984	
PLS 849	

Description of corner evidence found:

Corner not previously established.

Description of monument and accessories | established to perpetuate the original location of this corner:

Set 2-1/2"x30" aluminum pipe with 2-1/2" aluminum cap, stamped as shown on the **DIAGRAM**, SET 26" in the ground.

From which.

A Tamarack

18" dia. Bears, N13°W., 24.6 ft., scribed: W1/16 SS BT

A Lodgepole Pine 10" dia. Bears, S87°E., 25.7 ft., scribed: W1/16 SS BT

Measurements to trees taken with a metal tape and magnetic compass, with declination set off 20 deg. East.

Nailed a brass washer stamped PLS 849 on blaze above BT scribe, Bearing Tree Sign above blaze, and warning sign on back of each tree. Painted a 6" red band at breast ht. around each tree. Set steel fence posts with warning & Boundary Signs, North & West 5 ft. from the corner.


RECEIVED BY

Morrow County Surveyor

Date 1-10-86

Signature J.M.C.

Signature 781-K

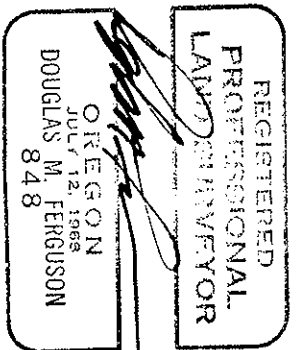

Work by D.M. Ferguson, PLS 848, Mt. Vernon Ore.
On Aug. 7, 1984
Witnessed by J. David Brinton, PLS 2065

Office of SURVEYOR County of WASCO
State of OREGON I hereby certify that the within instrument was filed in this office
for record on the 10 day of SEPTEMBER, 1985
David H. Krambs by B. H. H. H. Raymond
(COUNTY OFFICIAL) (DEPUTY)