

CERTIFIED RECORD OF LAND CORNER MONUMENTATION

INDEX No. E-7

History of original corner establishment:

Corner originally established in 1881, by Edward W. Sanderson, under General Land Office Contract No. 417. Surveyor General's Notes State: (See official GLO Notes)

DIAGRAM	
(not on cap)	
(TSS R28E)	
S5	
1/4-----	
S8	
1938	
GLO	

In 1938 Leonard Carter, Cadastral Engineer for the "General Land Office" performed a Dependent Resurvey, Those Notes State: Proportionate measure set an iron post, 3 ft. long, 1 ins. diam.; 28 ins. in the ground, for 1/4 sec. cor., with brass cap mkd. (see DIAGRAM), from which:
A lodgepole pine, 8 ins. diam., bears, N14°W., 53 lks. dist. mkd. 1/4 S5 BT
A white fir, 9 ins. diam., bears, S38°W., 79 lks. dist. mkd. 1/4 S8 BT

Description of corner evidence found:

Found 1" iron pipe, with 2-1/2" brass cap, stamped as shown on the **DIAGRAM**, set 8" above the ground.

Found a Fir 25" dia., live in good condition, with blaze healed over, bears record S38°W., 52.1 ft.

Found lodgepole Pine snag 5 ft. high with scribbling visible, bears record N14°E., 35.0 ft.

Description of monument and accessories | established to perpetuate the original location of this corner:

Maintained corner by setting steel posts with warning and boundary signs North S.5 ft. and South S.5 ft. from the corner.

Maintained accessories by nailing bearing tree & warning signs to existing original bearing trees as taken in 1938, and painted a 6" red band around said existing trees, at breast ht.


New Bearing Trees:

A Fir 7" dia. Bears, N13°W., 18.5 ft., scribed: 1/4 S5 BT

A Fir 11" dia. Bears, S38°E., 15.5 ft., scribed: 1/4 S8 BT

Measurements to trees taken with a metal tape and magnetic compass, with Declination set off 20 deg. East.

Nailed a brass washer stamped PLS 848 on blaze above BT scribe, Bearing Tree Sign above blaze, and warning sign on back of each new tree. Painted a 6" red band at breast ht. around each new tree.

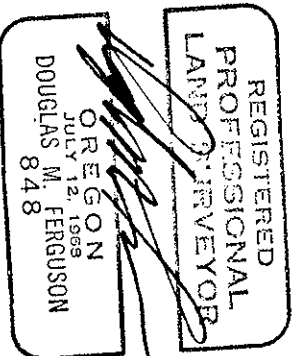

Work by D.M. Ferguson, PLS 848, Mt. Vernon Ore.
On Aug. 6, 1984
Witnessed by J. David Brinton, PLS 2065

Office of... S.W. Veyor... 1... County of... MORROW...
State of... OREGON... I hereby certify that the within instrument was filed in this office
for record on the... 10... day of... September... 1985
... David H. Krimmlein... by... Brent Reynolds...
(COUNTY OFFICIAL) (DEPUTY)

Form R6-7100-57 (9/71)

* GPO-798-276

RECORDED BY
INDEXED BY
1-10-86
MLD
749-K