

CERTIFIED RECORD OF LAND CORNER MONUMENTATION

INDEX No. E-9

History of original corner establishment:

Corner originally established in 1981, by Edward W. Sanderson, under General Land Office Contract No. 417. Surveyor General's Notes State: Set sandstone 12x11x9 ins., 8 ins. in the ground for corner to secs. 4,5,9 & 7, marked with 5 notches on S and 4 notches on E edges.

DIAGRAM	
T55 R28E	
S51S4	

S81S9	
1938	
6L0	

In 1938 Leonard Carter, Cadastral Engineer for the "General Land Office" performed a Dependent Resurvey, Those Notes State: Proportionate measure set an iron post, 3 ft. long, 2 ins. diam., 28 ins. in the ground, for cor., secs. 4,5,9 & 9 with brass cap mkd. (see DIAGRAM) From which:

A Lodgepole pine 7 ins. diam., bears N44°W., 57 lks. mkd. T55 R28E S4 BT
 A " " 10 ins. diam., bears S49°E., 91 lks. mkd. T55 R28E S9 BT
 A Tamarack 39 ins. diam., bears S25°W., 68 lks. mkd. T55 R28E S8 BT
 Description of corner evidence found: diam., bears N57°W., 121 lks. mkd. T55 R28E S5 BT

Found a 2-1/2" brass cap monument, stamped as shown on the **DIAGRAM**, set 8" above the ground. From which:


Found a Fir 24" dia., live, in good condition, with blaze healed over, bears N57W., 73.7 ft.,
 Found a Lodgepole pine, 10" dia., dead, bears record, N44E., 37.6 ft.

Description of monument and accessories | established to perpetuate the original location of this corner:

Maintained Corner monument by setting a steel post with warning and boundary signs, West, 5 ft. from the corner.

Maintained Accessories by painting a 6" red band around the original bearing trees, and nailing Bearing Tree & Warning Signs to the original trees.

New Bearing Trees:
 A Fir 11" dia. Bears, N28°E., 16.2 ft., scribed: T55 R28E S4 BT
 A Fir 12" dia. Bears, S 35°E., 48.3 ft., scribed: T55 R28E S9 BT
 A Fir 6" dia. Bears, S46°W., 19.1 ft., scribed: S8 BT
 Measurements to trees taken with a metal tape and magnetic compass, with Declination set off 20 deg. East.
 Nailed a brass washer stamped PLS 849 on blaze above BT scribe, Bearing Tree Sign above blaze, and warning sign on back of each tree. Painted a 6" red band at breast ht. around each tree.

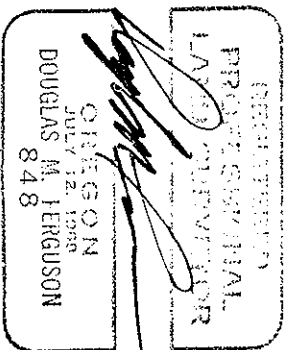

RECEIVED BY

Marrow County Surveyor

Date 1-10-86

Rec'd by MLD

No. 737-K

Work by D.M. Ferguson, PLS 849, Mt. Vernon Ore.
 On Aug. 6, 1994
 Witnessed by J. David Brinton, PLS 2065

Office of SUNNEYA County of WASCO
 State of OREGON I hereby certify that the within instrument was filed in this office
 for record on the 10th day of SEPTEMBER, 1986
David H. Kram by Brent Reynolds
 (COUNTY OFFICIAL) (DEPUTY)