

CERTIFIED RECORD OF LAND CORNER MONUMENTATION

INDEX No. F-2

History of original corner establishment:

None. Corner established this survey.

DIAGRAM

T55 R28E
NW 1/16

S7
1992
PLS 848

Description of Corner Evidence Found:


None. Corner established this survey.

Description of monument and accessories I established to perpetuate the original location of this corner:

Set 2-1/2"x30" aluminum pipe with 3-1/2" aluminum cap, stamped as shown on the DIAGRAM, 28" in the ground.
From Which:

Ponderosa Pine, 14" dia., bears S80°51'W, 37.2 ft., scribed: NW 1/16 S7 BT
Ponderosa Pine, 16" dia., bears N18°22'E, 28.8 ft., scribed: NW 1/16 S7 BT

Measurements to BT's taken with an Electronic Tacheometer with bearings based on the survey control network. Set steel fence post with Land Survey Monument (54-9) and Property Boundary (54-2) signs 5' north and east of the monument. Nailed a brass washer stamped PLS 848 on blaze above BT scribe as taken this survey. Nailed Bearing Tree (54-3) signs above blaze and Land Survey Monument (54-9) signs on back of each tree as required. Painted a 6" red band above Bearing Trees signs and painted blaze red.

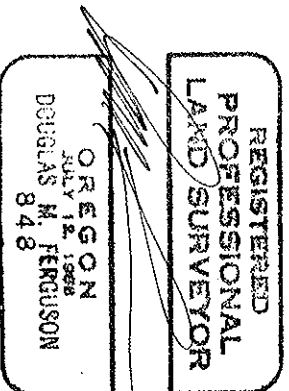

This work was performed by:
Douglas M. Ferguson PLS 848
Witnessed by: D. Mitchell Ferguson
and Rick Sauli
April 20, 1992
Refer to Morrow Co. Survey No.: C-938-E

Office of _____ County of MORROW
State of OR I hereby certify that the within instrument was
filed in this office for record on the 9 day of July, 1992
by SB
(COUNTY OFFICIAL) (DEPUTY)