

CERTIFIED RECORD OF LAND CORNER MONUMENTATION

INDEX No. F-3

History of original corner establishment:

None. Corner established this survey.

DIAGRAM

T5S R28E

C

N1/16 | S 7

C

1992

PLS 848

Description of Corner Evidence Found:


None. Corner established this survey.

Description of monument and accessories I established to perpetuate the original location of this corner:

Set 2-1/2"x30" aluminum pipe with 3-1/2" aluminum cap, stamped as shown on the DIAGRAM, 28" in the ground.
From Which:

Douglas Fir, 10" dia., bears N67°27'W, 48.0 ft., scribed: C-N1/16 S7 BT
Ponderosa Pine, 24" dia., bears N69°55'E, 62.6 ft., scribed: C-N1/16 S7 BT

Measurements to BT's taken with an Electronic Tacheometer with bearings based on the survey control network. Set steel fence post with Land Survey Monument (54-9) and Property Boundary (54-2) signs 5' north and west of the monument. Nailed a brass washer stamped PLS 848 on blaze above BT scribe as taken this survey. Nailed Bearing Tree (54-3) signs above blaze and Land Survey Monument (54-9) signs on back of each tree as required. Painted a 6" red band above Bearing Trees signs and painted blaze red.

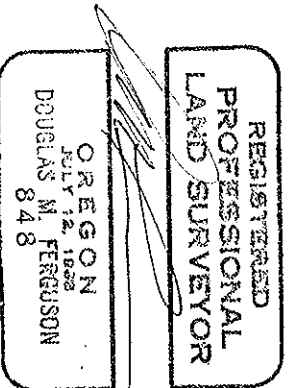

This work was performed by:
Douglas M. Ferguson PLS 848
Witnessed by: D. Mitchell Ferguson
and Rick Saul
April 20, 1992
Refer to Morrow Co. Survey No.: C-938-E

Office of MORROW County of MORROW
State of OR I hereby certify that the within instrument was
filed in this office for record on the 9 day of JULY, 1992
by SB (DEPUTY)
(COUNTY OFFICIAL)