


CERTIFIED RECORD OF LAND CORNER MONUMENTATION

INDEX No. F-7

History of original corner establishment:  
Corner not previously established.


TSS R28E

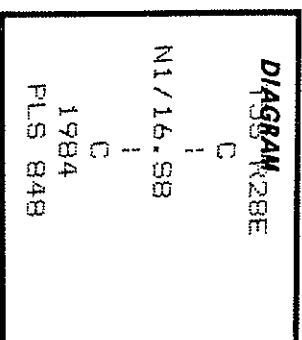

Description of corner evidence found:  
Corner not previously established.

Description of monument and accessories | established to perpetuate the

original location of this corner: 1/2" aluminum pipe with 2-1/2" aluminum cap, stamped as shown on the DIAGRAM, SET 24" in the ground.  
From which:  
A Tamarack 6" dia. Bears, S38° 10.5 ft., scribed: C-N 1/16 S8 BT  
A Tamarack 6" dia. Bears, N19° 3.9 ft., scribed: C-N 1/16 S8 BT  
Measurements to trees taken with a metal tape and magnetic compass, with Declination set off 20 deg. East.  
Nailed a brass washer stamped PLS 848 on blaze above BT scribe, Bearing tree sign above blaze, and warning sign on back of each tree. Painted a 6" red band at breast ht. around each tree. Set steel fence posts with warning & Boundary Signs, North 3 ft. and East 4 ft. from the corner.

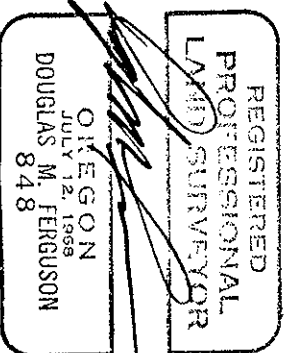

Work by D.M. Ferguson, PLS 848, Mt. Vernon Ore.  
On Aug. 7, 1984  
Witnessed by J. David Brinton, PLS 2065

16

State of OREGON I hereby certify that the within instrument was filed in this office  
for record on the 10th day of September, 1985  
David H. Krumbein by Raymond  
(COUNTY OFFICIAL) (DEPUTY)

Form R6-7100-57 (9/71)

1-10-86  
M.L.D.  
748-K