


CERTIFIED RECORD OF LAND CORNER MONUMENTATION

F-9

History of original corner establishment:

Unsurveyed - subdivided Section.

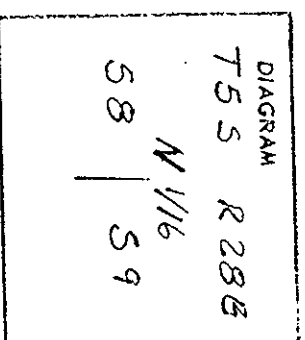

No record of subsequent remonumentation found in County Records.

Description of corner evidence found:

No evidence found.

I set the monument described below at the midpoint between the found W 1/4 and the NW corner of Section 15.

REGISTERED  
PROFESSIONAL  
LAND SURVEYOR

*Terry E. Hamby*  
OREGON  
JULY 14, 1978  
TERRY E. HAMBY  
1638

Description of monument and accessories I established to perpetuate the original location of this corner

At the position described above, I set a 2 1/2" x 30" iron pipe 24" in the ground, with a brass cap marked as shown:

From which I scribed BTs:

A lodgepole pine 15" in diam. bears S 02° E 8.3' marked N 1/16 S 9 T 55 R 28E BT with signs.  
A lodgepole pine 11" in diam. bears S 82° W 37.2' marked N 1/16 S 8 T 55 R 28E BT with signs.

I nailed a brass washer marked PLS 1638 to the BT blazes.


I set a steel fence post 5' West and 5' South with signs.

I painted a red band around the BTs and face of scribe.

I used a steel tape and a magnetic compass with 21° East variation and measured a horizontal distance to the center of BTs.

This corner was set October 22, 1979.

Witness by Roderick D. PUNCHES and Dennis L. PASASCH.

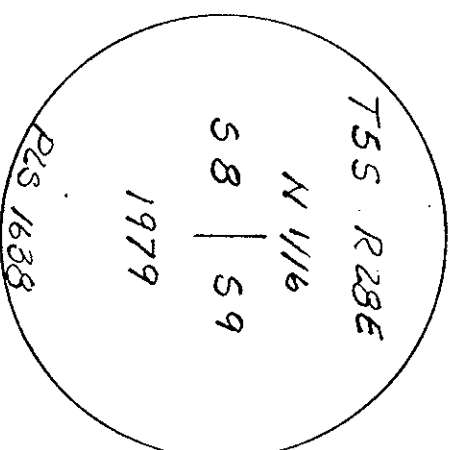

Office of \_\_\_\_\_ County Surveyor \_\_\_\_\_ County of \_\_\_\_\_ MORTWOW \_\_\_\_\_  
 State of OREGON, I hereby certify that the within instrument was filed in this office  
 for record on the 4 day of Dec 1979  
*Dennis L. Pasasch*  
 (COUNTY OFFICIAL) by \_\_\_\_\_ (DEPUTY)

RECEIVED BY

Mortwow County Surveyor  
 Date 12-10-79  
 Rec'd By *M.P.J.*  
 No. 268-K

*corner scribed during drawing*