


CERTIFIED RECORD OF LAND CORNER MONUMENTATION

INDEX No. F-9

**History of original corner establishment:**

Corner originally established in 1979 by Terry E. Hamby, PLS 1638, while subdividing this section 9, for the Umatilla National Forest. CERTIFIED RECORD OF LAND CORNER MONUMENTATION form prepared by him states: At midpoint between the found W1/4 and the NW Corner of section 15 (should be sec. 9 ?) I set a 2-1/2"x30" iron pipe, 24" in the ground, with a brass cap marked as shown (See DIAGRAM) from which I scribed Bts:  
 A lodgpole pine 15" diam. bears S02°0'E., 8.3' marked N1/16 S9 T55 R28E BT  
 A lodgpole pine 11" diam. bears S82°0'W., 37.2' marked N1/16 S8 T55 R28E BT  
 I nailed a brass washer marked PLS 1638 to BT blazes.  
 I set a steel fence post 5' west and 5' south with signs.  
 I painted a red band around the Bts and face of scribe.

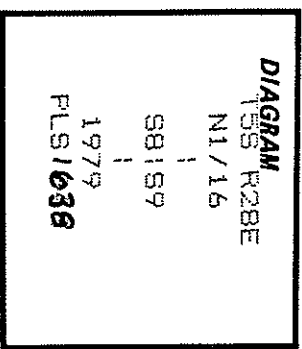


**Description of corner evidence found:**

Found 2-1/2" brass cap monument stamped as shown on the DIAGRAM  
 Found both bearing trees as described in history, dead and standing, at record bearing and distance.

**Description of monument and accessories | established to perpetuate the original location of this corner:**

Maintained corner by setting steel posts West 5 ft. and South 5 ft. from the corner, with warning and boundary signs attached. Maintained accessories by painting a 6" red band around the original bearing trees, the proper signs are in place.  
 New Accessories.  
 A lodgpole pine 8" dia. Bears, West, 31.1 ft., scribed: N1/16 S8 BT.  
 Set a 5/8"x30" iron pin with plastic cap, stamped, PLS 848 SURVEY MARKER, and set a steel fence post with Bearing tree & Warning signs attached, alongside the pin, Bears, East, 8.9 ft.  
 Measurements to trees taken with a metal tape and magnetic compass, with Declination set off 20 deg. East.  
 Nailed a brass washer stamped PLS 848 on blaze above BT scribe, Bearing tree sign above blaze, and warning sign on the new tree. Painted 6" red band at breast ht. around the new tree as well as the trees taken in 1979. *band*

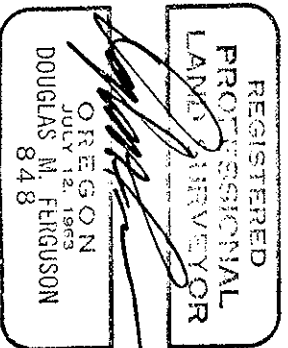

Work by D.M. Ferguson, PLS 848, Mt. Vernon Ore.  
 On Aug. 8, 1984  
 Witnessed by J. David Brinton, PLS 2065

 State of Oregon, I hereby certify that the within instrument was filed in this office for record on the 10<sup>th</sup> day of September, 1985  
David H. Krumboltz by David H. Krumboltz Reynolds  
 (COUNTY OFFICIAL) (DEPUTY)

Form R6-7100-57 (9/71) RECEIVED BY MUD Morrow County Surveyor  
 LUG 1-10-86  
 746-K  
 \* GPO—798-276