


CERTIFIED RECORD OF LAND CORNER MONUMENTATION

G-10

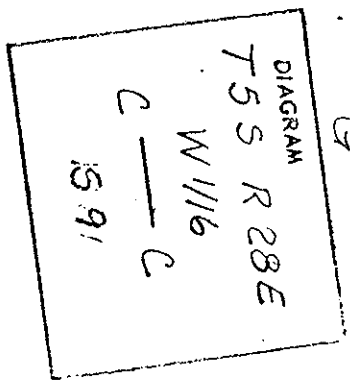

History of original corner establishment:
Unsurveyed - subdivided Section.

No record of subsequent remonumentation found in County Records.

Description of corner evidence found:
No evidence found.

I set the monument described below at the midpoint between the found W 1/4 and the computed C 1/4 of Section 9.

Description of monument and accessories I established to perpetuate the original location of this corner:
At the position described above, I set a 2 1/4" x 30" iron pipe 21" in the ground, with a brass cap marked as shown:

From which I scribed BTs:
A fir 10" in diam. bears East 18.1' marked CW 1/16 S 9 BT with signs.
A lodgepole pine 12" in diam. bears S 18 W 15.5' marked CW 1/16 S 9 BT with signs.

I nailed a brass washer marked PLS 1638 to the BT blazes.


I set a steel fence post 5' East and 6' West.

I painted a red band around the BTs and face of scribe.

I used a steel tape and a magnetic compass with 21° East variation and measured a horizontal distance to the center of BTs.

This corner was set October 22, 1979.
Witness by Roderick D. Punches.

REGISTERED
PROFESSIONAL
LAND SURVEYOR
Terry E. Hamb
JULY 14, 1978
TERRY E. HAMB
1638

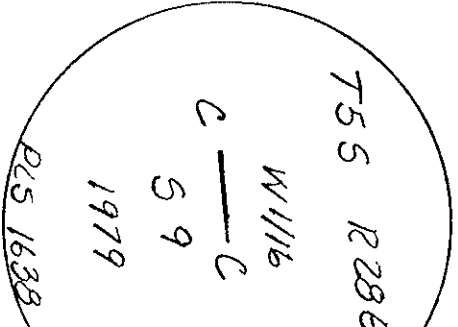

Office of Morrow County Surveyor
State of Oregon
I hereby certify that the within instrument was filed in this office
by David H. Ham
COUNTY OFFICIAL

RECEIVED BY
Morrow County Surveyor
Date 10-10-79
Rec'd By CMJ
No. 968-1