


CERTIFIED RECORD OF LAND CORNER MONUMENTATION

G-11

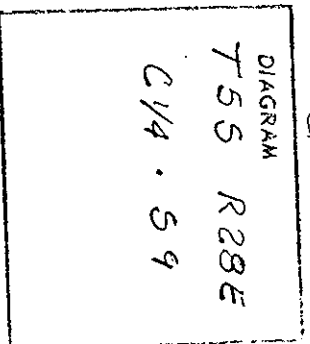

History of original corner establishment:
Unsurveyed - subdivided Section.

No record of subsequent remonumentation found in County Records.

Description of corner evidence found:
No evidence found.

I set the monument described below at the point of intersection of the four found $\frac{1}{4}$'s of Section 9.

REGISTERED
PROFESSIONAL
LAND SURVEYOR

Terry E. Hamby

OREGON
JULY 14, 1978
TERRY E. HAMBY
1638


Description of monument and accessories I established to perpetuate the original location of this corner

At the position described above, I set a $2\frac{1}{2}$ " x 30" iron pipe 26" in the ground, with a brass cap marked as shown:

From which I scribed BTs:

A tamarack 13" in diam. bears N 87° E $11\frac{3}{4}$ ' marked C $\frac{1}{4}$ S 9 T 5S R 28E BT with signs.
A lodgepole pine 16" in diam. bears S 27° W 20.4' marked C $\frac{1}{4}$ S 9 T 5S R 28E BT with signs.

I nailed a brass washer marked PLS 1638 to the BT blazes.
I set a steel fence post 5' North and 5' West.
I painted a red band around the BTs and face of scribe.
I used a steel tape and a magnetic compass with 21° East variation and measured a horizontal distance to the center of BTs.
This corner was set October 24, 1979.
Witness by Roderick D. Punches.

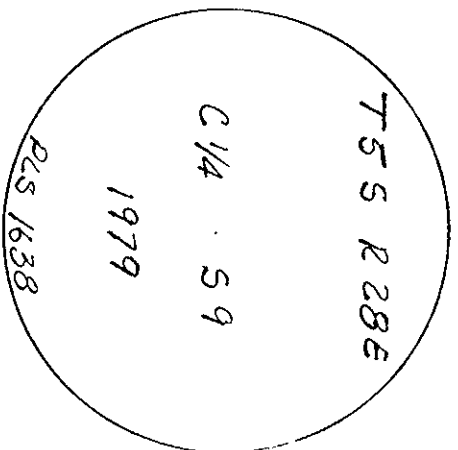

Office of County Surveyor County of MORROW

State of Oregon I hereby certify that the within instrument was filed in this office RECEIVED BY

for record on the 4th day of Dec 1979

Roderick D. Punches (COUNTY OFFICIAL) by (DEPUTY)

Morrow County Surveyor

Date 10-10-79

Rec'd By *SMJS*

No. 268-K

