


**CERTIFIED RECORD OF LAND CORNER MONUMENTATION**

Refer to: Plat of Penland 1988 Cadastral Survey  
Sections 11 and 14, T.5S., R.28E., W.M.

G-19

History of original corner establishment:  
No record of previous monumentation.

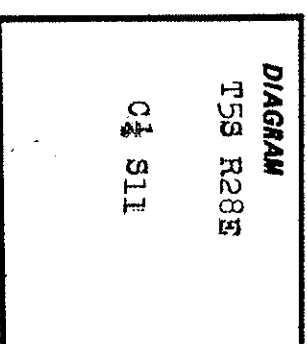

Description of corner evidence found:  
None.

Description of monument and accessories established to perpetuate the original location of this corner:

At the corner point I set a 2 1/2" x 30" alum. pipe with a 2 1/2" alum. cap

T5S R28E  
C1/2 S11E  
PLS 1832  
1988

Monument is 25" in the ground and surrounded by a mound of stone.

From the corner:

A white fir, 11" dia., N79°E, 25.3 ft.; marked: C1/2 S11 BT  
A white fir, 17" dia., S42 3/4°E, 57.3 ft.; marked C1/2 S11 BT

BTs have blaze and a 6" band painted red, BT tags, "Land Survey Monument" signs and alum. "PLS 1832" washers nailed to the bottom of the blaze. There is a 6' steel fence post with a "Land Survey Monument" sign within 5' of the corner.

Measured to center of BTs using steel tape and staff compass. Magnetic declination set at 190E.

July 26, 1988


RECEIVED BY

Morrow County Surveyor

Date 11/88

Rec'd By LORAK

No. C 872K

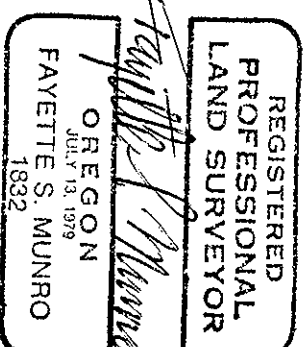

Office of..... County of.....

State of..... I hereby certify that the within instrument was filed in this office

for record on the..... day of....., 19.....

..... by ..... (DEPUTY)  
(COUNTY OFFICIAL)