

CERTIFIED RECORD OF LAND CORNER MONUMENTATION


Refer to: Plat of Penland 1988 Cadastral Survey
Sections 11 and 14, T.5S., R.28E., W.M.

Page 1 of 2
G-21

History of original corner establishment:

E.W. Sanderson under G.L.O. contract no. 417, dated Aug. 24, 1881 set a basalt stone 15"x 10"x 6", 10" in the ground. He marked BTs:
A Fir, 9" dia., west, 57 lks.
A Fir, 35" dia., N75°E, 39 lks.

Leonard Carter, Public Land Surveyor, under G.L.O. special instructions, Group No. 228, dated March 25, 1938; found the original stone and remonumented the corner with a 1"x 36" iron pipe with a brass cap marked:

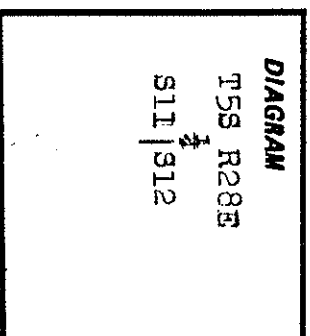

From the corner:
A dead Douglas fir, 27" dia., N71°E, 35 lks.; with healed blaze. S11 | S12
A Douglas fir, 21" dia., N82°W, 61 lks.; with evidence of scribing. 1938
(continued on Page 2 of 2.)

Description of corner evidence found:

I found a scattered mound of stone. From the corner point, located at record distance from the 1938 BTs:

A Douglas Fir stump, 14" dia., N69°W, 60.7 ft.; with scribing visible.
A Douglas Fir, 28" dia., N83 1/2°W, 40.7 ft.; with healed blaze.
This BT has a second stem southerly with scribing visible.
A Douglas Fir, 18" dia., S36°E, 41.6 ft.; with healed blaze.
A badly rotted stump, approx. 3' dia., N71°E, 23.1 ft.; with scribed tree lying on ground southerly.

Description of monument and accessories | established to perpetuate the original location of this corner:

At record distance from the two BTs marked in 1938 I set a 2 1/2"x 30" alum. pipe with a 2 1/2" alum. cap containing a magnet and marked:
Monument is 18" in the ground and surrounded by a mound of stone. T5S R28E
S11 | S12
PLS 1832
1988

BTs have blaze and a 6" band painted red, BT tags and "Land Survey Monument" signs. There is a 6' steel fence post with a "Land Survey Monument" sign within 5' of the corner.

Measured to center of BTs using steel tape and staff compass. Magnetic declination set at 20°E.

July 27, 1988

RECEIVED BY

Morrow County Surveyor

REGISTERED
PROFESSIONAL
LAND SURVEYOR

Date 11/1988
Rec'd By LOHAR
No. E 872K

Robert S. Munro
OREGON
JULY 13, 1879
FAYETTE S. MUNRO
1832

Office of..... County of.....
State of....., I hereby certify that the within instrument was filed in this office
for record on the..... day of....., 19.....
..... by (DEPUTY)
(COUNTY OFFICIAL)