

CERTIFIED RECORD OF LAND CORNER MONUMENTATION

Refer to: Plat of Penland 1988 Cadastral Survey
Sections 11 and 14, T.5S., R.28E., W.M.


Page 2 of 2
G-21

History of original corner establishment:
(Continued from Page 1 of 2.)
Quarter marked new BTs;
A Douglas fir, 6" dia., S361°0E, 63 lks.
A Douglas fir, 15" dia., N671°0W, 92 lks.

DIAGRAM
T5S R28E
1
S11 | S12

Description of corner evidence found:

Description of monument and accessories | established to perpetuate the
original location of this corner:

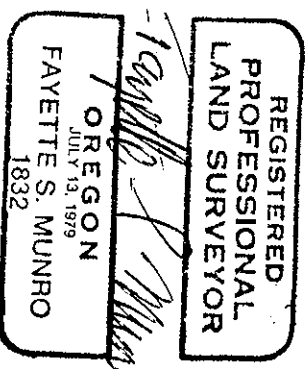

Office of..... County of.....
State of....., I hereby certify that the within instrument was filed in this office
for record on the..... day of....., 19.....

..... by RECEIVED BY (DEPUTY)
(COUNTY OFFICIAL)

Form R6-7100-57 (9/71)

Morrow County Surveyor

Date 11/88

Rec'd by OHK

No. 08722K