

CERTIFIED RECORD OF LAND CORNER MONUMENTATION

INDEX No. G-3

History of original corner establishment:

None. Corner established this survey.

DIAGRAM

T55 R28E

C1/4

S7

1992

PLS 848

Description of Corner Evidence Found:


None. Corner established this survey.

Description of monument and accessories I established to perpetuate the original location of this corner:

Set 2-1/2"x30" aluminum pipe with 3-1/2" aluminum cap, stamped as shown on the DIAGRAM, 28" in the ground.  
From which:

Ponderosa Pine, 24" dia.,	bears N08°02'E, 57.0 ft.,	scribed: C1/4 S7 BT
White Fir, 12" dia.,	bears S82°22'E, 51.2 ft.,	scribed: C1/4 S7 BT
Red Fir, 16" dia.,	bears S49°56'E, 39.3 ft.,	scribed: C1/4 S7 BT
White Fir, 16" dia.,	bears S45°03'W, 31.7 ft.,	scribed: C1/4 S7 BT

Measurements to BT's taken with an Electronic Tacheometer with bearings based on the survey control network. Set steel fence post with Land Survey Monument (54-9) sign 5' north of the monument. Nailed a brass washer stamped PLS 848 on blaze above BT scribe as taken this survey. Nailed Bearing Tree (54-3) signs above blaze and Land Survey Monument (54-9) signs on back of each tree as required. Painted a 6" red band above Bearing Trees signs and painted blaze red.

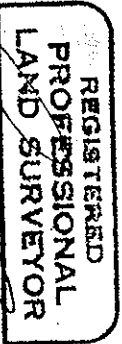

OREGON  
JULY 12, 1988  
DOUGLAS M. FERGUSON  
848

This work was performed by:  
Douglas M. Ferguson PLS 848  
Witnessed by: D. Mitchell Ferguson  
and Rick Sauli  
April 21, 1992  
Refer to Morrow Co. Survey No.: C-938-E

Office of \_\_\_\_\_ County of MORROW  
State of OR I hereby certify that the within instrument was  
filed in this office for record on the 9 day of July, 1992  
by SB  
(COUNTY OFFICIAL) (DEPUTY)