

CERTIFIED RECORD OF LAND CORNER MONUMENTATION

INDEX No. B-9

History of original corner establishment finished in 1881, by
 corner originally established by Edward W. Sanderson, under General Land Office
 Contract No. 417. Surveyor General's Notes
 State: (See official GLO Notes)

DIAGRAM on cap)
(TSS R28E)
1/4
1
S81S9
1938
GLO

In 1938 Leonard Carter, Cadastral Engineer for the "General Land Office" performed a Dependent Resurvey, Those Notes State: Proportionate measure set an iron post, 3 ft. long, 1 ins. diam., 28 ins. in the ground, for 1/4 sec. cor., with brass cap mkd. (see DIAGRAM). From which:
 A lodgepole pine 4 ins. diam., bears S82°E., 38 lks. mkd. 1/4 S9 BT
 A lodgepole pine 6 ins. diam., bears S64°W., 63 lks. mkd. 1/4 S8 BT


Description of corner evidence found:

Found 1" iron pipe with 2-1/2" brass cap, stamped as shown on the **DIAGRAM**, set 8" above the ground.

Found both Bearing trees as scribed in 1938, and described above, Sec. 8 BT is dead & standing, Sec. 9 BT is dead & down. Both trees are at record measurement from the monument.

Description of monument and accessories | established to perpetuate the original location of this corner:

Maintained Corner by setting a steel post with Boundary & Warning Signs North 5 ft. from the corner.
 Maintained Accessories by nailing Bearing Tree & Warning Signs to the original dead bearing trees, and painting 6" red band around the original Bearing Trees.
 New Bearing Trees:
 A Lodgepole Pine, 8" dia. Bears, N53W., 19.7 ft.; scribed: 1/4 S8 BT
 A " " 10" dia. Bears, N82E., 6.8 ft.; scribed: 1/4 S9 BT
 Measurements to trees taken with a metal tape and magnetic compass, with Declination set off 20 deg. East.
 Nailed a brass washer stamped PLS 848 on blaze above BT scribe, Bearing Tree Sign above blaze, and warning sign on back of each tree. Painted a 6" red band at breast ht. around each tree.

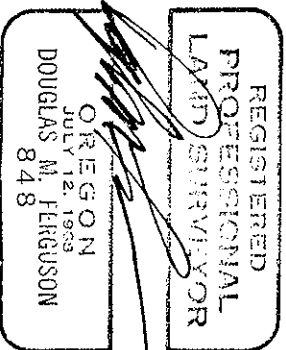

Work by D.M. Ferguson, PLS 848, Mt. Vernon Ore.
 On Aug. 9, 1984
 Witnessed by J. David Brinton, PLS 2065

Office of Surveyor 14 County of Wallowa
 State of Oregon, I hereby certify that the within instrument was filed in this office
 for record on the 10th day of September, 1985
David H. Krumbein by David H. Reynolds
 (COUNTY OFFICIAL) (DEPUTY)

Form R6-7100-57 (9/71)

RECORDED BY

Wallowa County Surveyor

IN 1-10-86

PLS MLD

747-K