


CERTIFIED RECORD OF LAND CORNER MONUMENTATION

H-17

History of original corner establishment:

Unsurveyed - subdivided section.

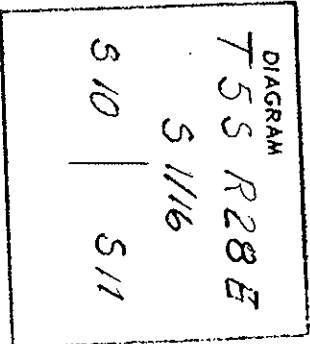

No record of subsequent remonumentation found in County Records.

Description of corner evidence found:

No evidence found.

I set the monument described below at the midpoint between the found E 1/4 and the SE corner of Section 10.

REGISTERED
PROFESSIONAL
LAND SURVEYOR


Terry E. Hamby
OREGON
JULY 14, 1978
TERRY E. HAMBY
1638

Description of monument and accessories | established to perpetuate the original location of this corner

At the position described above, I set a 2 1/2" x 30" iron pipe 21" in the ground with a brass cap marked as shown:

From which I scribed BTs:

A fir 8" in diam. bears N 61° W 11.0' marked S 1/16 S 10 T 5S R 28E BT with signs.
A fir 16" in diam. bears N 15° E 43.7' marked S 1/16 S 11 T 5S R 28E BT with signs.

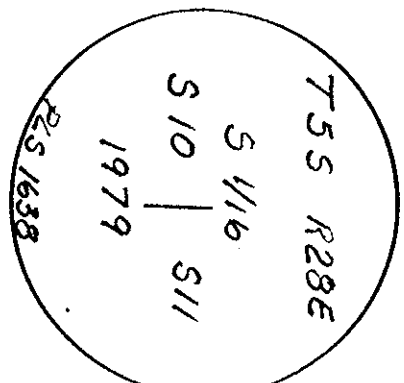

I nailed a brass washer marked PLS 1638 to the BT blazes.

I set a steel fence post 5' South and 5' East.

I painted a red band around BTs and face of scribe.

I used a steel tape and a magnetic compass with 21° East variation and measured a horizontal distance to the center of BTs.

This corner was set October 23, 1979.

Witness by W. Keith Sands.

Office of County Surveyor County of MORROW
State of OREGON I hereby certify that the within instrument was filed in this office
for record on the day of Dec. 1979
David H. Kelly by (DEPUTY)
(COUNTY OFFICIAL)

RECEIVED BY
Morrow County Surveyor
Date 12-10-79
Rec'd By WMAI
No. 269-K