


CERTIFIED RECORD OF LAND CORNER MONUMENTATION

Refer to: Plat of Penland 1988 Cadastral Survey
Sections 11 and 14, T.5S., R.28E., W.M.

H-19

History of original corner establishment:
No record of previous monumentation.

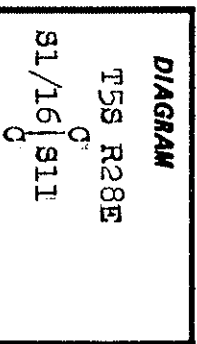

Description of corner evidence found:
None.

Description of monument and accessories established to perpetuate the original location of this corner:
At the corner point I set a 2 1/2" x 30" alum. pipe with a 2 1/2" alum. cap
containing a magnet and marked;
Monument is 26" in the ground. S1/16 S11 1988

From the corner:
A Western Larch, 20" dia., S40°E, 53.3 ft.; marked: CS1/16 S11 BT
A Douglas Fir, 18" dia., S58°W, 100.0 ft.; marked: CS1/16 S11 BT
BTs have blaze and a 6" band painted red, BT tags, "Land Survey Monument" signs and alum. "PLS 1832" washers nailed to the bottom of the blaze.
There is a 6' steel fence-post with a "Land Survey Monument" sign within 5' of the corner.
Measured to center of BTs using steel tape and staff compass. Magnetic declination set at 18 3/4°E.
July 27, 1988

RECEIVED BY
Morrow County Surveyor

Date 11/1988
Rec'd By CHIK
No. C 8721K

REGISTERED
PROFESSIONAL
LAND SURVEYOR

Fayette S. Munro

OREGON
JULY 13, 1979
FAYETTE S. MUNRO
1832

Office of..... County of.....
State of..... I hereby certify that the within instrument was filed in this office
for record on the..... day of....., 19.....
..... by
(COUNTY OFFICIAL) (DEPUTY)