

RECORD OF LAND CORNER MONUMENTATION

SOUTH 1/4 CORNER SECTION 9, T. 5 S., R. 28 E., W.M.


ORIGINALLY ESTABLISHED BY: Edward W. Sanderson, U.S. Deputy Surveyor

CONTRACT NUMBER: 417

CONTRACT DATE: August 24, 1881

SUBSEQUENT SURVEYS:

- ▶ 1938/1939 Dependant Resurvey by Leonard Carter, Public Land Surveyor for the General Land Office, under Group No. 228 approved May 2, 1938
- ▶ Remonumentation performed by David L. Haddock, PLS 852, see corner certificate filed 11/92 in the Morrow County Surveyor's records

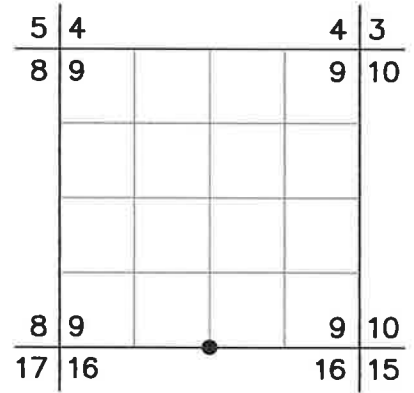

SANDERSON'S 1881 DESCRIPTION: set sandstone 12x9x6 ins 8 ins in ground for 1/4 Sec. Cor. marked 1/4 on N. face from which

A Fir 8 in dia bears N15°E, 27 lks dist marked 1/4 S B.T.

A Fir 11 in dia. bears S20°W, 35 lks dist marked 1/4 S B.T.

CARTER'S 1938 DESCRIPTION: Proportionate measurement, set an iron post, 3 ft. long, 1 in. diam., 28 ins. in the ground, for 1/4 sec. cor., with brass cap mkd. (diagram shown), from which:

A lodgepole pine, 10 ins. diam., bears N.23°W., 47 lks. dist., mkd. 1/4 S 9 B T

A lodgepole pine, 10 ins. diam., bears S.6°E., 30 lks. dist., mkd. 1/4 S 16 B T

HADDOCK'S 1992 DESCRIPTION: Found the iron post with standard GLO brass cap stamped as shown in the diagram. From which:

A 13" dbh Lodgepole Pine stump bears N37°25'W, 30.8' with scribe.

A 16" Lodgepole Pine bears S9°56'E, 20.1' with scribe.

I set the following new witness tree:

A 8" dbh Lodgepole Pine bears N56°14'E, 141.1' scribed 1/4S9BT;

A 6" dbh Lodgepole Pine bears S79°51'E, 83.1' scribed 1/4S16BT;

A 7" dbh Lodgepole Pine bears S31°43'W, 67.7' scribed 1/4S16BT;

A 11" dbh Lodgepole Pine bears N25°36'W, 45.1' scribed 1/4S9BT

EVIDENCE FOUND: Found a 1" iron pipe with attached 2 1/2" GLO brass cap (marked as shown below) projecting 12" above ground with no visible mound of stone, along an east-west fence. From which, I found the following bearing trees:

- ▶ A lodgepole pine snag, 4 ft. tall, bears N.56°14'E., 141.1 ft. with scribing visible in an open blaze (1992 BT)
- ▶ A lodgepole pine, dead and down, bears S.9°56'E., 20.1 ft. with scribing visible in an open blaze (1939 BT)
- ▶ A lodgepole pine, 13" dbh, bears S.13°43'W., 67.7 ft. with scribing visible in an open blaze (1992 BT)
- ▶ A lodgepole pine, 11.5" dbh, bears N.79°51'W., 83.1 ft. with healed blaze (1992 BT)
- ▶ A lodgepole pine, dead and down, bears N.25°46'W., with scribing visible (1992 BT)

DESCRIPTION OF MONUMENTS AND ACCESSORIES SET AND METHODS USED:

I accept the found brass-capped monument for the true corner position. I raised a mound of stone around the monument, 2 ft. diameter base to top of cap.

From which, I SCRIBE THE FOLLOWING NEW BEARING TREE:


- ▶ A lodgepole pine, 11" dbh bears N.42°E., 9.60 ft. marked "1/4 S9" in upper blaze, and "BT" in lower blaze

I also SET THE FOLLOWING REFERENCE POINT:

- ▶ A 5/8"x30" iron pin driven flush with the ground bears N.45°W., 14.25 ft., with attached 2" aluminum cap marked "RP 1 2021 PLS 69454"

Painted a 6 inch red band around the bearing trees, and also painted the blazes red, and attached USFS signs 54-3 and 54-9. Distances measured with a steel tape. Distance to new bearing tree was measured to a 60d nail driven in the side-center-left at the root crown of the tree. Bearings were measured with a magnetic compass with 14° East declination.

MONUMENT MARKED:

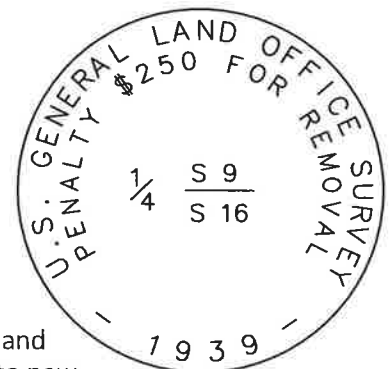

RESTORATION BY, STAMP AND DATE:

Work Performed October 6, 2021 by:

Jason L. Hatfield, PLS

USDA FOREST SERVICE
NORTHEAST OREGON LAND ZONE
1550 Dewey Avenue, Suite A
Baker City, OR 97814
(541) 523-1337

RECEIVED BY
Morrow County Surveyor

Date: 1-5-2022
Rec'd By: MPK
No.: 5528J11
Folder No.: _____

