

CERTIFIED RECORD OF LAND CORNER MONUMENTATION

History of original corner establishment:

Index: J-11

|   |   |          |   |
|---|---|----------|---|
| Quarrier corner secs. 9 & 16, T.55., R.22E., W.11.    | 1 | DIAGRAM  | 1 |
| Original survey of township by Sanderson in 1891.     | 1 |          | 1 |
| His record reads: Set 12x5x6 sandstone for 1/4 corner | 1 |          | 1 |
| from which:   | 1 |          | 1 |
| A 8" fir bears N15°E, 27 lks.                         | 1 | 89       | 1 |
| A 11" fir bears S20°W, 24 lks.                        | 1 | 1/4----- | 1 |
|   | 1 | 816      | 1 |
|   | 1 | 1908     | 1 |

Township retraced by Carter of GLD in 1938.

His record reads:

|   |   |  |   |
|---|---|--|---|
| Set iron post 3 ft. long, 1 in. diam, 27 ins. in the        | 1 |  | 1 |
| ground for 1/4 sec. cor., with brass cap mkd: (see diagram) | 1 |  | 1 |
| A 10" lodgepole bears N23°W, 47 lks.                        | 1 |  | 1 |
| A 10" lodgepole bears S6°E, 30 lks.                         | 1 |  | 1 |

Description of corner evidence found:

Found the iron post with standard GLD brass cap stamped as shown in the diagram. From which:

A 10" dbh Lodgepole pine stum bears N37°25'W, 30.6' with scribe.

A 15" Lodgepole pine bears S9°56'E, 20.1' with scribe.

Description of monument and accessories I established to perpetuate the original location of this corner:

The bearings were based on the surveyed bearing between the NE corner and the North 1/4 corner of section 16 as recorded in by PLS 1638 in Morrow County survey 259-K. I set the following new witness trees:

A 6" dbh Lodgepole pine bears N56°14'E, 141.1' scribed 1/4S16BT1


A 6" dbh Lodgepole pine bears S79°51'E, 53.1' scribed 1/4S16BT1

A 7" dbh Lodgepole pine bears S31°43'W, 57.7' scribed 1/4S16BT1


A 11" dbh Lodgepole pine bears N25°36'W, 45.1' scribed 1/4S9BT1

An aluminum washer stamped PLS 852 is nailed between the letters B and T on the new trees. All the BT's have LSM and BT signs attached. Painted 6" red bands around all the trees and painted the scribe blazes red.

This work was done September 23, 1952.

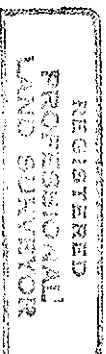

*David L. Haddock*

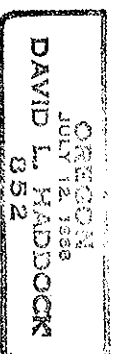

Office of \_\_\_\_\_ County of \_\_\_\_\_  
 State of \_\_\_\_\_, I hereby certify that the within instrument was filed  
 in this office for record on the \_\_\_\_\_ day of \_\_\_\_\_, 19\_\_\_\_.  
 \_\_\_\_\_ BY \_\_\_\_\_ (DEPUTY)  
 ( COUNTY OFFICIAL )

Form RE-7100-57 (9/71)

RECEIVED BY

Morrow County Surveyor

Date 11/9/52

Rec'd By [Signature]

No. \_\_\_\_\_