


CERTIFIED RECORD OF LAND CORNER MONUMENTATION

J-7

History of original corner establishment:

Corner originally established 1882 under Contract Survey No. 417, dated 1881.

Corner re-established by Dependent Resurvey authorized 1938 and approved Feb. 21, 1941.

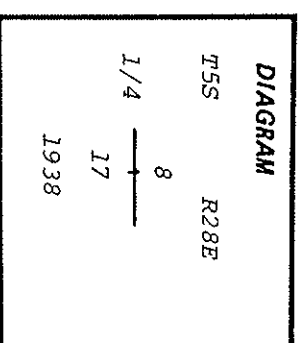


Description of corner evidence found:
1 inch iron pipe, with 2 1/2 inch brass cap marked as shown above, from which---
17" White Fir, alive and standing, bears N 57° E (record N 66° E), 31.0' (record 31.0') blaze healed, scar visible.
14" White Fir, alive and standing, bears S 25° W (record S 26° W), 11.0' (record 11.2'), blaze healed, scar visible.

Description of monument and accessories | established to perpetuate the original location of this corner:

Attached USFS signs 54-4 and 54-3 to both bearing trees, painted blazes, and a 6" band of fluorescent red paint around all trees.

Set 6' steel post 5' East of corner and attached USFS sign 54-4.

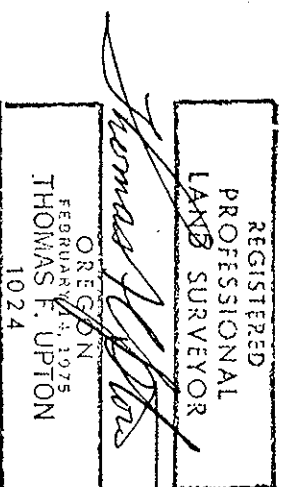

Thomas F. Upton, Certificate No. R.L.S. 1024

Office of Co. Surveyor County of MORROW
State of Oregon, I hereby certify that the within instrument was filed in this office
for record on the 12th day of January, 1982
by Donald H. Krumbein by Margaret A. Hughes
(COUNTY OFFICIAL) (DEPUTY)

RECEIVED BY

Form R6-7100-57 (9/71)

Morrow County Surveyor

☆ GPO—798-276

Date January 12, 1982

Rec'd By M. Hughes

No. 461-K

Ref. drwg. NO C-459-K