

CERTIFIED RECORD OF LAND CORNER MONUMENTATION

INDEX No. J-9

History of original corner establishment:

Corner originally established in 1881, by Edward W. Sanderson, under General Land Office Contract No. 417. Surveyor General's Notes State: (See official GLO Notes)

DIAGRAM
155 R29E
58159

5171516
1938
GLO

In 1938 Leonard Carter, Cadastral Engineer for the "General Land Office" performed a Dependent Resurvey, Those Notes State: Proportional measure set an iron post, 3 ft. long, 2 ins. diam., 28 ins. in the ground, for cor. secs. 8,9,16 and 17, with brass cap. mkd. (See **DIAGRAM**). From which:
A Douglas fir, 5 ins. diam., bears N40°E., 48 lks. mkd. T55 R28E S9 BT
A white fir, 5 ins. diam., bears S60°E., 21 lks. mkd. T55 R28E S16 BT
A Tamarack, 7 ins. diam., bears S56°W., 38 lks. mkd. T55 R28E S17 BT
A Tamarack, 7 ins. diam., bears N35°W., 57 lks. mkd. T55 R28E S8 BT
Description of corner evidence found:

Found a 2" iron pipe with 2-1/2" brass cap stamped as shown on the **DIAGRAM**, set 8" above the ground.


Found bearing trees as established in 1938, all live in good condition with blazes healed over, at record measurement from the brass cap mon., as follows.
NE tree, a Spruce, 12" dia. (Record is Douglas Fir)
SE tree, a Fir, 13" dia.
SW tree, a Tamarack 10" dia.
NW tree, a Tamarack 10" dia.
Found a steel post set 6 ft. east from the monument.

Description of monument and accessories | established to perpetuate the original location of this corner:

Maintained Corner by attaching a warning sign to the existing fence post, which is 6 ft. East from the Monument.

Maintained Accessories as follows:
Measurements to trees taken with a metal tape and magnetic compass, with Declination set off 20 deg. East.

All required signs are in place on all trees.
Painted 6" red band at breast ht. around each tree.

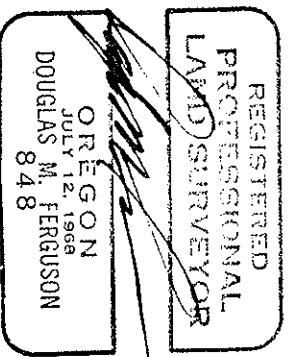

Work by D.M. Ferguson, PLS 848, Mt. Vernon Ore.
On Aug. 8, 1984
Witnessed by J. David Brinton, PLS 2065

State of Oregon I hereby certify that the within instrument was filed in this office
for record on the 10th day of September 1985
David H. Krause by David R. Brinton
(COUNTY OFFICIAL) (DEPUTY)

Form R6-7100-57 (9/71)

RECORDED BY
Kenneth Conroy Surveyor

1-10-86
MLD
750-K