


CERTIFIED RECORD OF LAND CORNER MONUMENTATION

K-116

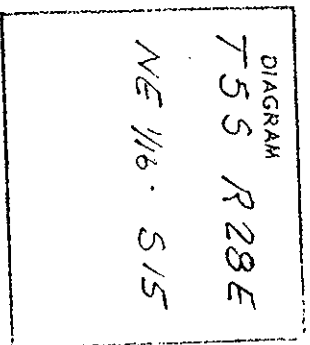

History of original corner establishment:
Unsurveyed - subdivided Section.

No record of subsequent remonumentation found in County Records.

Description of corner evidence found:
No evidence found.

I set the monument described below at the point of intersection of the four computed 1/16's, the W 1/16 to the N 1/16 and the E 1/16 to the CE 1/16.

Description of monument and accessories I established to perpetuate the original location of this corner

At the position described above, I set a 2 1/2" x 30" iron pipe 10" in the ground, with a brass cap marked as shown:

From which I scribed BTs:

A fir 18" in diam. bears N 87° E 27.9' marked NE 1/16 S 15 BT.
A fir 9" in diam. bears S 74° W 61.6' marked NE 1/16 S 15 BT.

I raised a 4' rock mound around the corner.
I nailed a brass washer marked PLS 1638 to the BT blazes.


I set a steel fence post 6' South and 5' East.
I painted a red band around the BTs and face of scribe.

I used a steel tape and a magnetic compass with 21° East variation and measured a horizontal distance to the center of BTs.

This corner was set October 23, 1979.

Witness by W. Keith Sands.

REGISTERED
PROFESSIONAL
LAND SURVEYOR
Terry E. Hamby
OREGON
JULY 14, 1978
TERRY E. HAMBY
1638

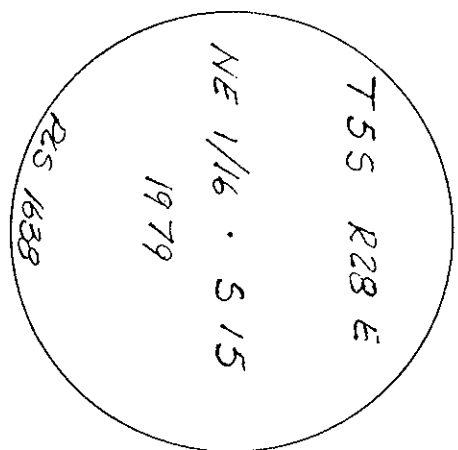

Office of _____ County Surveyor _____ County of _____ MORROW
State of Oregon, I hereby certify that the within instrument was filed in this office
for record on the _____ day of Dec. 1975
David H. Allen by _____ (DEPUTY)
(COUNTY OFFICIAL)

RECEIVED BY
Morrow County Surveyor
Date 10-10-79
Rec'd By MAI
No. 269-K

Concealing drawing