


CERTIFIED RECORD OF LAND CORNER MONUMENTATION

L-15

History of original corner establishment:

Unsurveyed - subdivided Section.

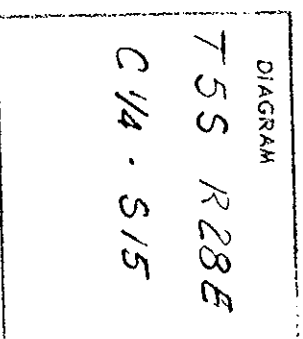

No record of subsequent remonumentation found in County Records.

Description of corner evidence found:

No evidence found.

I set the monument described below at the point of intersection of the four found $\frac{1}{4}$'s of Section 15.

Description of monument and accessories I established to perpetuate the original location of this corner

At the position described above, I set a $2\frac{1}{2}$ " x 30" iron pipe 26" in the ground, with a brass cap marked as shown:

From which I scribed BTs:

A tamarack 9" in diam. bears N 44° E 20.3' marked C $\frac{1}{4}$ S 15 T 5S R 28E BT.
A tamarack 10" in diam. bears S 33° W 13.4' marked C $\frac{1}{4}$ S 15 T 5S R 28E BT.

I nailed a brass washer marked PLS 1638 to the BT blazes.

I set a steel fence post 5' West with signs 54-4.

I painted a red band around the BTs and face of scribe.


I used a steel tape and a magnetic compass with 21° East variation and measured a horizontal distance to the center of BTs.

This corner was set October 19, 1979.

Witness by Dennis L. Paasch and W. Keith Sands.

REGISTERED
PROFESSIONAL
LAND SURVEYOR

Terry E. Hamby
OREGON
JULY 14, 1978
TERRY E. HAMBY
1638

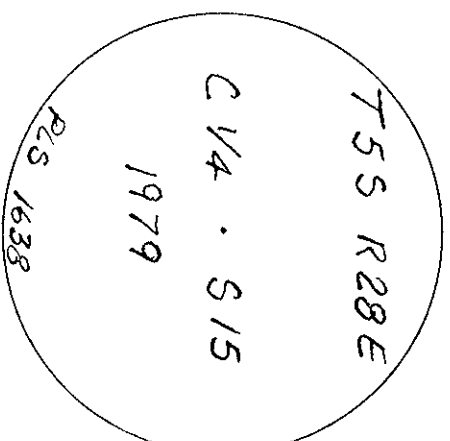

Office of _____ County Surveyor _____ County of _____ Morrow _____
 State of Oregon, I hereby certify that the within instrument was filed in this office
 for record on the 14th day of Dec. 1979.
Candace H. Allen
 (COUNTY OFFICIAL) by _____ (DEPUTY)

RECEIVED BY
 Morrow County Surveyor
 Date 12-10-79
 Rec'd By MAF
 No. 569-R

conresponding drawing