


CERTIFIED RECORD OF LAND CORNER MONUMENTATION

L-5

History of original corner establishment:

Corner originally established 1882 under Contract Survey No. 417, dated 1881.

Corner re-established by Dependent Resurvey authorized 1938 and approved Feb. 21, 1941.

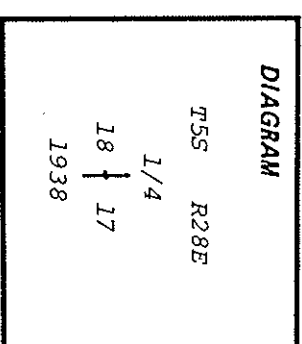

Description of corner evidence found:

2 inch iron pipe with 2 1/2 inch brass cap marked as shown above, from which---

15" Doug Fir, alive and standing, bears N 55° E (record), 11.7' (record 11.9'), blaze healed, scar visible.

19" Tamarack, alive and standing, bears S 86° W (record), 33.7' (record), scribing 1/4 S 18 BT legible.

Description of monument and accessories | established to perpetuate the original location of this corner:

Attached USFS signs, 54-4 and 54-3 to Bearing Trees, painted blazes and a 6 inch wide band around trunks.

Set 6' steel fence post 5' North of corner with USFS signs, 54-2 over 54-4.

REGISTERED
PROFESSIONAL
LAND SURVEYOR

Thomas F. Upton

OREGON
FEBRUARY 4, 1975
THOMAS F. UPTON
1024

Thomas F. Upton, Certificate No. R.L.S. 1024

Office of Geo. Sullivan..... County of Morrow.....
 State of Oregon..... I hereby certify that the within instrument was filed in this office
 for record on the 12th day of January, 1982
Thomas F. Upton..... by Maitha A. Alaphes.....
 (COUNTY OFFICIAL) (DEPUTY)

Form R6-7100-57 (9/71)

RECEIVED BY
Morrow County Surveyor ☆ GPO—798-276
 Date January 12, 1982
 Rec'd By M. Alaphes
 No. 463-K
 Ref. drwg. no. C-459-K