

CERTIFIED RECORD OF LAND CORNER MONUMENTATION

L-7


History of original corner establishment:

Section in which this Corner is located was originally surveyed under Contract Survey No. 417, dated 1881.

This Section was later included in Dependent Resurvey authorized in 1938 and approved Feb. 21, 1941.

Note:

The Corner identified by this record was not monumented in connection with either of the surveys noted above.

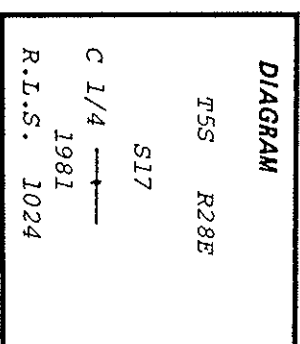

Description of corner evidence found:  
Corner not previously monumented.

Description of monument and accessories | established to perpetuate the original location of this corner:

At the location of this corner, as established by Survey, set a 2 1/2 inch alum. pipe, 30 inches long, 2 feet in the ground, with an alum. cap marked as shown above.  
From this monument as set,  
New Bearing Tree, a 12 " White Fir, bears N 49° E, a distance of 62.2 feet, which I marked, C 1/4 S 17 BT.  
New Bearing Tree, an 11" White Fir, bears S 21° E, a distance of 41.5 feet, which I marked, C 1/4 S 17 BT.  
Attached USFS signs, 54-3 and 54-9, to Bearing Trees, and painted a 6" wide band, and blazes, with fluorescent red paint. Attached brass tag, marked R.L.S 1024.  
Set 6' steel fence post 3' North of corner and attached USFS signs, 54-2 over 54-9.

REGISTERED PROFESSIONAL LAND SURVEYOR
<i>Thomas F. Upton</i>
OREGON FEBRUARY 1, 1975 THOMAS F. UPTON 1024

Thomas F. Upton, Certificate No. R.L.S. 1024

Office of...*Dr. Swanson*... County of...*Morrow*...  
State of...*Oregon*... I hereby certify that the within instrument was filed in this office  
for record on the...*12th* day of...*JANUARY*... 1982.  
...*Dorothy H. Krumbein*... by *Martha A. Nishchek*...  
(COUNTY OFFICIAL) (DEPUTY)

Form R6-7100-57 (9/71)

RECEIVED BY  
Morrow County Surveyor  
★ GPO—798-276

Date...*January 12, 1982*  
Rec'd By...*M. Nishchek*  
No. *469-K*  
Ref. draw. no. C-459-K