


CERTIFIED RECORD OF LAND CORNER MONUMENTATION

M-13

Mistery of original corner establishment:

Unsurveyed - subdivided Section.

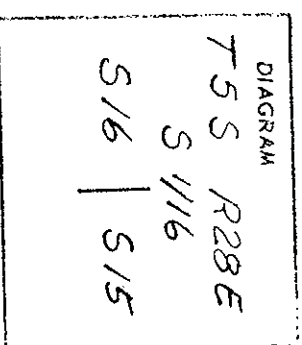

No record of subsequent remonumentation found in County Records.

Description of corner evidence found:

No evidence found.

I set the monument described below at the midpoint between found SE corner and W 1/4 of Section 15.

Description of monument and accessories I established to perpetuate the original location of this corner

At the position described above, I set a 2 1/2" x 30" iron pipe 18" in the ground, with a brass cap marked as shown:


From which I scribed Bts:

REGISTERED
PROFESSIONAL
LAND SURVEYOR

Angie C. Hamby

JULY 14, 1978
TERRY E. HAMBY
1638

A fir 12" in diam. bears N 33° E 18.00' marked S 1/16 S 15 T 5S R 28E BT.
A fir 11" in diam. bears N 88° W 30.9' marked S 1/16 S 15 T 5S R 28 BT.

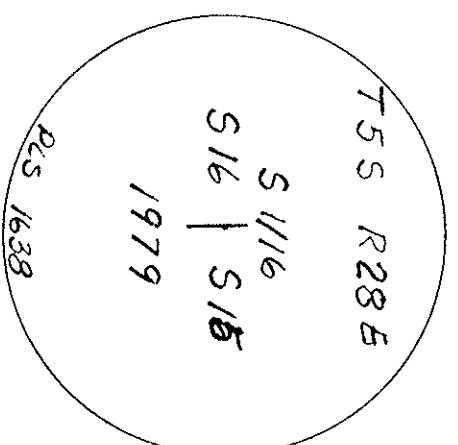

I nailed a brass washer marked PLS 1638 to the BT blazes.

I set a steel fence post 5' North and 5' East.

I painted a red band around the Bts and face of scribe.

I used a steel tape and a magnetic compass with 21° East variation and measured a horizontal distance to the center of Bts.

This corner was set October 17, 1979.

Witness by Dennis L. Paasch and W. Keith Sands.

Office of County Surveyor County of MORROW
State of Oregon, I hereby certify that the within instrument was filed in this office
for record on the 5th day of Dec. 1979
Dandy H. Kline (COUNTY OFFICIAL) by (DEPUTY)

RECEIVED BY
Morrow County Surveyor
Date 12-10-79
Rec'd By MTI
No. 269-R

Consolidating
drawing