


CERTIFIED RECORD OF LAND CORNER MONUMENTATION

M-15

History of original corner establishment:

Unsurveyed - subdivided Section.

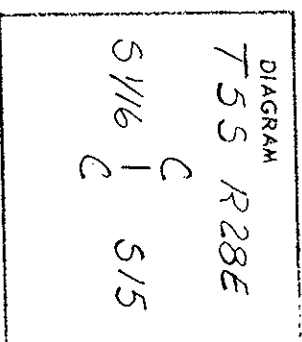

No record of subsequent remonumentation found in County Records.

Description of corner evidence found:

No evidence found.

I set the monument described below at the midpoint between the found S 1/4 and the computed C 1/4 of Section 15.

Description of monument and accessories established to perpetuate the original location of this corner

At the position described above, I set a 2 1/4" x 30" iron pipe 24" in the ground, with a brass cap marked as shown:

From which I scribed BTs:

A pine 7" in diam. bears N 25° E 70.8' marked C S 1/16 S 15 BT.
A pine 12" in diam. bears N 27° W 51.7' marked C S 1/16 S 15 BT.

I nailed a brass washer marked PLS 1638 to the BT blazes.

I set a steel fence post 5' West and 5' East with signs 54-2 and 54-4.

I painted a red band around the BTs and face of scribe.

I used a steel tape and a magnetic compass with 21° East variation and measured a horizontal distance to the center of BTs.


This corner was set October 19, 1979.

Witness by Dennis L. Paasch and W. Keith Sands.

REGISTERED
PROFESSIONAL
LAND SURVEYOR

Terry E. Hamby

OREGON
JULY 14, 1978
TERRY E. HAMBY
1638

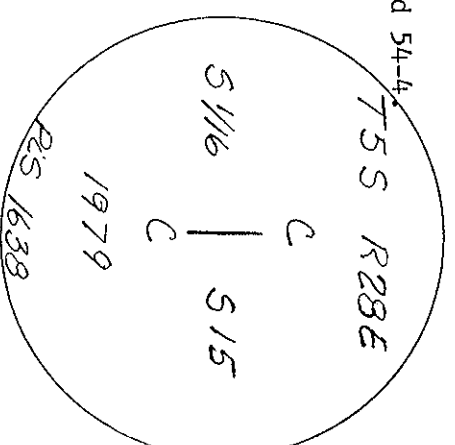

Office of _____ County Surveyor _____ County of _____ MORROW _____
 State of Oregon, I hereby certify that the within instrument was filed in this office
 for record on the _____ day of _____ Dec. 1979
David H. Kline by _____
 (COUNTY OFFICIAL) (DEPUTY)

RECEIVED BY
 Morrow County Surveyor
 Date 12-10-79
 Rec'd By WMT
 No. 269-K

