


# RECORD OF LAND CORNER MONUMENTATION

WEST 1/16 CORNER SECTIONS 16 AND 21, T. 5 S., R. 28 E., W.M.

ORIGINALLY ESTABLISHED BY: Thomas F. Upton, PLS 1024

COUNTY SURVEYOR DOCUMENTATION: Map of Survey recorded 1/12/82 as C-460-K-465 and associated monumentation record filed 1/12/82

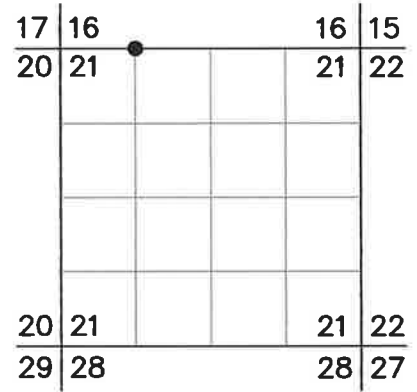

**ORIGINAL DESCRIPTION:** At the location of this corner, as established by survey, set a 2 1/2 inch" alum. pipe, 30 inches long, 2 feet in the ground, with an alum. cap marked as shown above. From this monument as set, New Bearing Tree, a 7" White Fir, bears N 1° W a distance of 29.5 feet, which I marked W 1/16 S16 BT New Bearing Tree, an 11" White Fir, bears S 21° W a distance of 40.6 feet, which I marked W 1/16 S21 BT

**EVIDENCE FOUND:** Found a 2 1/2" aluminum pipe with 2 3/4" aluminum cap projecting 2" above ground in a 1 1/2 ft. mound of stone. From which, I found the following bearing trees:  
 A white fir 16" dbh bears N.01°W., 29.5 ft., with healed double blaze  
 A white fir snag broken off at 14" above ground and leaning loose against other trees, with scribing visible in double blazes. Broken stump bears S.21°W., 40.6 ft. from corner.


**DESCRIPTION OF MONUMENTS AND ACCESSORIES SET AND METHODS USED:**

I accept the found aluminum monument for the true corner position.

**MONUMENT MARKED:**

From which, I SCRIBE THE FOLLOWING NEW BEARING TREES:

- ▶ A Douglas-fir, 19" dbh bears S.45°W., 25.50 ft. marked "W1/16 S21" in upper blaze and "BT" in lower blaze

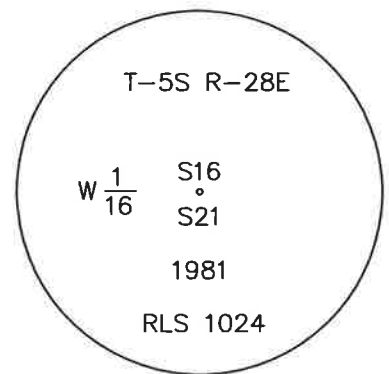

Painted a 6 inch red band around the bearing trees, and also painted the blazes red. Attached USFS signs 54-3 and 54-9 to the bearing trees. Distance to new bearing tree was measured with a steel tape to a 60d nail driven in the side-center-right at the root crown. Bearings were measured with a magnetic compass with 14° East declination.

**RESTORATION BY, STAMP AND DATE:**

Work Performed September 29, 2021 by:

Jason L. Hatfield, PLS  
 Reid Kelly

USDA FOREST SERVICE  
 NORTHEAST OREGON LAND ZONE  
 1550 Dewey Avenue, Suite A  
 Baker City, OR 97814  
 (541) 523-1337

**RECEIVED BY**  
 Morrow County Surveyor  
 Date: 1-5-2022  
 Rec'd By: MPK  
 No.: SS28N10  
 Folder No.: \_\_\_\_\_

