

CERTIFIED RECORD OF LAND CORNER MONUMENTATION

U-10


History of original corner establishment:

The section in which this corner is located was originally surveyed under Contract Survey No. 417, dated 1881.

This section was later included in Dependent Resurvey authorized in 1938 and approved Feb. 21, 1941.

Note:

The corner identified by this record was not monumented in connection with either of the surveys noted above.

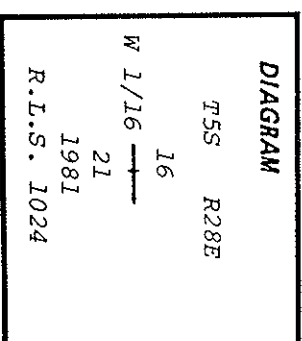

Description of corner evidence found:

Corner not previously monumented.

Description of monument and accessories | established to perpetuate the original location of this corner:

At the location of this corner, as established by survey, set a 2 1/2 inch alum. pipe, 30 inches long, 2 feet in the ground, with an alum. cap marked as shown above.


From this monument as set,

New Bearing Tree, a 7" White Fir, bears N 1° W a distance of 29.5 feet, which I marked W 1/16 S16 BT.

New Bearing Tree, an 11" White Fir, bears S 21° W a distance of 40.6 feet, which I marked W 1/16 S 21 BT.

Attached USFS signs 54-3 and 54-9 to Bearing Trees, attached brass tags marked R.L.S. 1024, and painted blazes and a 6" wide band of fluorescent red around trunks.

Set 6' steel fence post 5' North of Corner with USFS signs, 54-2 over 54-9.

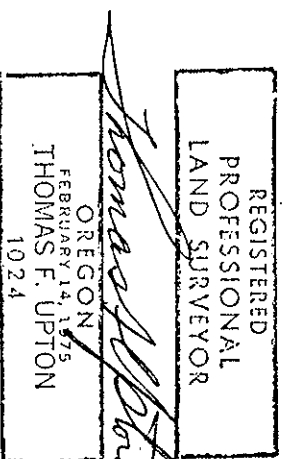

Thomas F. Upton, Certificate No. R.L.S. 1024

Office of Co. Surveyor ..... County of Morrow .....

State of Oregon ..... I hereby certify that the within instrument was filed in this office  
for record on the 12th day of January ..... 1982  
by David H. Kumbier ..... by Martha A. Hughes .....

(COUNTY OFFICIAL) (DEPUTY)

Form R6-7100-57 (9/71)

RECEIVED BY  
Morrow County Surveyor  
Date January 12, 1982  
Rec'd By M. Hughes  
No. 277-K  
Ref. drwa. no. C-440K

18 GPO-798-276