


# RECORD OF LAND CORNER MONUMENTATION

EAST 1/16 CORNER SECTIONS 16 AND 21, T. 5 S., R. 28 E., W.M.

ORIGINALLY ESTABLISHED BY: Thomas F. Upton, PLS 1024

COUNTY SURVEYOR DOCUMENTATION: Map of Survey recorded 1/12/82 as C-460-K-465 and associated monumentation record filed 1/12/82

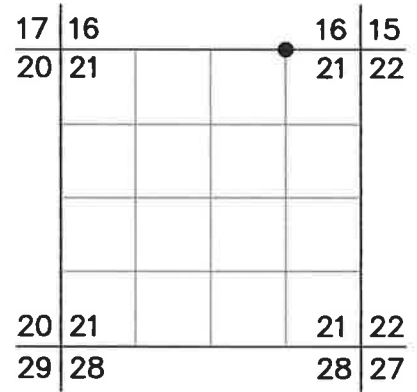

**ORIGINAL DESCRIPTION:** At the location of this corner, as established by survey, set a 2 1/2 inch alum. pipe, 30 inches long, 2 feet in the ground, with an alum. cap marked as shown above. From this monument as set, A Bearing Tree, a 6" L.P. pine, bears N 33° E, a distance of 19.2 feet, which I marked E 1/16 S16 BT. A Bearing Tree, a 14" Spruce, bears S 8° W, a distance of 48.2 feet, which I marked E 1/16 S21 BT.

**EVIDENCE FOUND:** Found a 2 1/2" aluminum pipe with 2 3/4" aluminum cap projecting 2" above ground with no visible mound of stone. From which, I found the following bearing trees:

- ▶ An Engelmann spruce 20" dbh bears S.08°W., 48.2 ft., with healed double blaze
- ▶ A lodgepole pine snag bears N.33°E., 19.2 ft., with visible scribing in an open double blaze

**DESCRIPTION OF MONUMENTS AND ACCESSORIES SET AND METHODS USED:**


I accept the found aluminum monument for the true corner position.

**I SET THE FOLLOWING REFERENCE POINT:**

- ▶ A 5/8"x30" iron pin driven flush with the ground bears N.57°W., 12.1 ft., with attached 2 1/2" aluminum cap marked "RP 1 2021 PLS 69454"

Painted a 6 inch red band around the bearing trees, and also painted the blazes red. Attached USFS signs 54-3 and 54-9 to the bearing trees. Distances measured with a steel tape. Bearings were measured with a magnetic compass with 14° East declination.

**MONUMENT MARKED:**

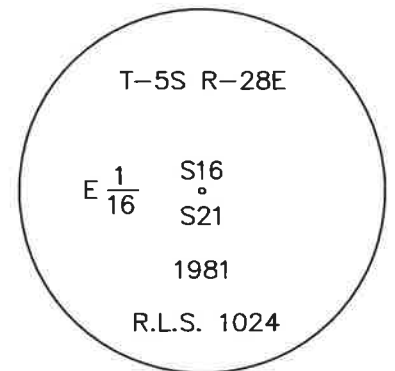

**RESTORATION BY, STAMP AND DATE:**

Work Performed October 5, 2021 by:

Jason L. Hatfield, PLS

USDA FOREST SERVICE  
NORTHEAST OREGON LAND ZONE  
1550 Dewey Avenue, Suite A  
Baker City, OR 97814  
(541) 523-1337

**RECEIVED BY**  
Morrow County Surveyor  
Date: 1-5-2022  
Rec'd By: MPK  
No.: SS28N12  
Folder No.: \_\_\_\_\_

