

CERTIFIED RECORD OF LAND CORNER MONUMENTATION

11-12


History of original corner establishment:

The Section in which this corner is located was originally surveyed under Contract Survey No. 417, dated 1881.

This section was later included in Dependent Resurvey authorized in 1938 and approved Feb. 21, 1941.

Note:

The corner identified by this record was not monumented in connection with either of the surveys noted above.

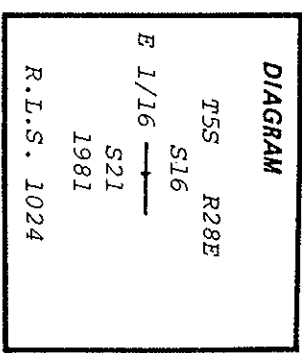

Description of corner evidence found:

Corner not previously monumented.

Description of monument and accessories | established to perpetuate the original location of this corner:

At the location of this corner, as established by survey, set a 2 1/2 inch alum. pipe, 30 inches long, 2 feet in the ground, with an alum. cap marked as shown above.

From this monument as set,

A Bearing Tree, a 6" L.P. pine, bears N 33° E, a distance of 19.2 feet, which I marked E 1/16 S16 BT.

A Bearing Tree, a 14" Spruce, bears S 8° W, a distance of 48.2 feet, which I marked E 1/16 S21 BT.

Attached USFS signs, 54-3 and 54-9, and a brass tag marked R.L.S. 1024, to all trees, and painted blazes and a 6" wide band of fluorescent red around trunks.

Set a 6' steel fence post 5' East of Corner and attached USFS signs, 54-2 over 54-9. Set a 6' steel fence post 5' South of Corner and attached USFS signs, 54-2 over 54-9.

REGISTERED
PROFESSIONAL
LAND SURVEYOR

Thomas F. Upton

OREGON
FEBRUARY 17, 1975
THOMAS F. UPTON
1024

Office of *Co. Swiney* County of *Morrow* Thomas F. Upton, Certificate No. R.L.S. 1024

State of *Oregon*, I hereby certify that the within instrument was filed in this office for record on the *12th* day of *January*, 1982
David H. Krumbein *Maatha A. Hughes*
(COUNTY OFFICIAL) (DEPUTY)

Form R6-7100-57 (9/71)

RECEIVED BY ☆ GPO-798-276

Morrow County Surveyor

Date *January 12, 1982*

Filed By *D. Hughes*

NO. *478-K*

Ref. dwg. no. *C-460-K*