


CERTIFIED RECORD OF LAND CORNER MONUMENTATION

N-13

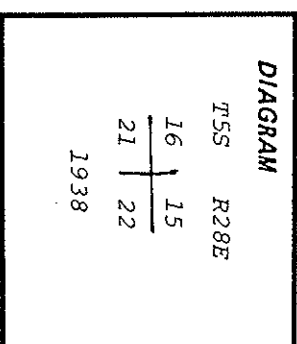

History of original corner establishment:
 Corner originally established 1882 under Contract Survey No. 417, dated 1881.
 Corner re-established by Dependent Resurvey authorized 1938 and approved Feb. 21, 1941.

Description of corner evidence found:

- 2 inch iron pipe with 2 1/2 inch brass cap, marked as shown above, from which---
- 20" stump, 2' high, bears N 45° E (record N 42° E), 40.3' (record 40.3'), no markings visible.
- 38" Tamarack, alive and standing, bears S 61° E (record S 65° E), 17.0' (record 17.2'), blaze healed, scar visible.
- 14" White Fir, alive and standing, bears N 69° W (record N 70° W), 13.1' (record 13.2'), blaze healed, scar visible.
- 18" Spruce, alive and standing, bears S 55° W (record S 50° W), 39.0' (record 38.9'), blaze healed, scar visible.

Description of monument and accessories | established to perpetuate the original location of this corner:

From Corner location as found and as described above,
 New Bearing Tree, a 10" Spruce, bears N 42° E a distance of 39.6 feet, which I marked T55 R28E S15 BT.

Attached USFS signs, 54-3 and 54-4, to all Bearing Trees, and attached a brass tag, marked R.L.S. 1024, to new tree. Painted blazes and a 6" wide band of fluorescent red around trunks.

Set 6' steel fence post 5' West of corner and attached USFS signs, 54-2 over 54-4.

REGISTERED PROFESSIONAL LAND SURVEYOR

Thomas F. Upton

OREGON
 FEBRUARY 17, 1975
 THOMAS F. UPTON
 1024

Thomas F. Upton, Certificate No. R.L.S. 1024

Office of Co. Surveyor..... County of... Morrow.....
 State of Oregon..... hereby certify that the within instrument was filed in this office
 for record on the 12th day of January....., 1982
 David H. Krumbein..... Martha A. Bishop
 (COUNTY OFFICIAL) (DEPUTY)

Form R6-7100-57 (9/71)

RECEIVED BY ☆ GPO-798-276

Morrow County Surveyor

Date January 12, 1982

Rec'd By M. Bishop

10-469-K

Ret. draw. no. C-41-7-1