


CERTIFIED RECORD OF LAND CORNER MONUMENTATION

N-14

History of original corner establishment:

Unsurveyed - subdivided Section.

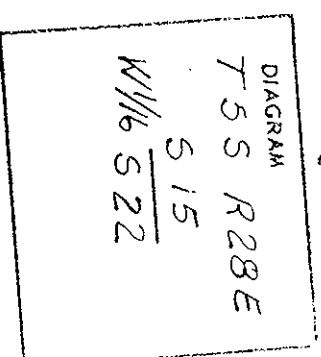

No record of subsequent remonumentation found in County Records.

Description of corner evidence found:

No evidence found.

I set the monument described below at the midpoint between the found SE corner and S 1/4 of Section 15.

REGISTERED
**PROFESSIONAL
 LAND SURVEYOR**


Terry E. Hamby
 OREGON
 JULY 14, 1978
TERRY E. HAMBY
 1638

Description of monument and accessories I established to perpetuate the original location of this corner

At the position described above, I set a 2 1/2" x 30" iron pipe 24" in the ground, with a brass cap marked as shown:

From which I scribed BTs:

A pine 12" in diam. bears N 48° E 13.60' marked W 1/16 S 15 T 5S R 28E BT.
 A pine 13" in diam. bears S 18° E 27.10' marked W 1/16 S 22 T 5S R 28E BT.

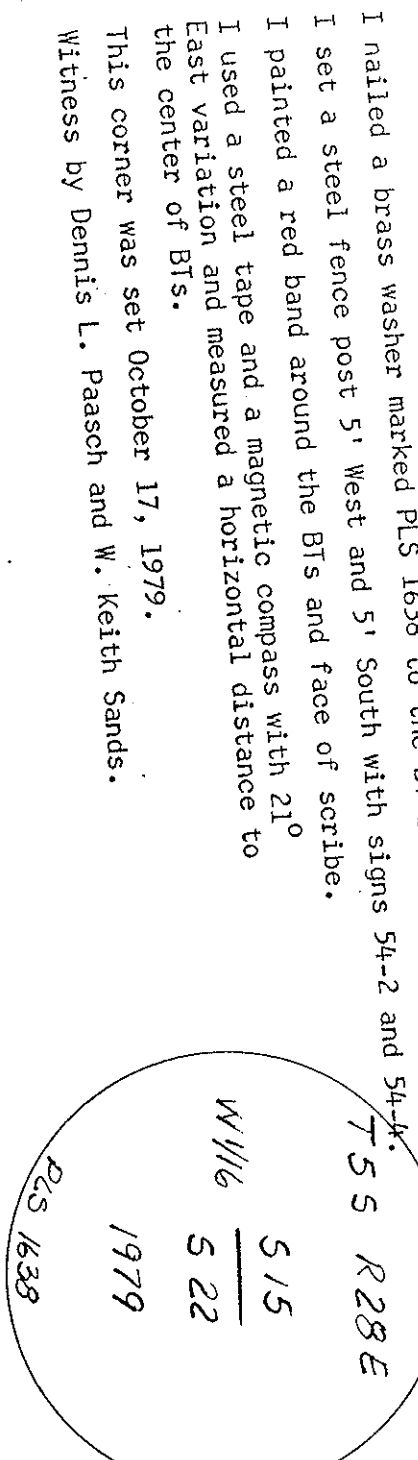

I nailed a brass washer marked PLS 1638 to the BT blazes.
 I set a steel fence post 5' West and 5' South with signs 54-2 and 54-4.
 I painted a red band around the BTs and face of scribe.
 I used a steel tape and a magnetic compass with 21° East variation and measured a horizontal distance to the center of BTs.

This corner was set October 17, 1979.
Witness by Dennis L. Paasch and W. Keith Sands.

Office of County Surveyor County of MORROW
 State of Oregon, I hereby certify that the within instrument was filed in this office
 for record on the 4 day of Dec. 1977 by Dennis L. Paasch (DEPUTY)
 (COUNTY OFFICIAL)

RECEIVED BY
Morrow County Surveyor
 Date 10-10-79