


CERTIFIED RECORD OF LAND CORNER MONUMENTATION

N-7

History of original corner establishment:

Corner originally established 1882 under Contract Survey No. 417, dated 1881.

Corner re-established by Dependent Resurvey authorized 1938 and approved Feb. 21, 1941.

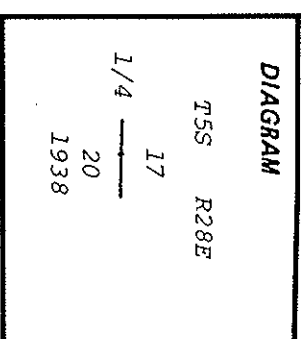

Description of corner evidence found:

1 inch iron pipe with 2 1/2 inch brass cap marked as shown above, from which--

19 " L.P. Pine, dead and standing, bears N 69° E (record N 70° E), 188.5' (record 188.1'), scribing 1/4 S 17 BT legible.

24" L.P. Pine, dead and standing, bears S 74° E (record S 73° E), 216.5' (record), scribing 1/4 S 20 BT legible.

Description of monument and accessories | established to perpetuate the original location of this corner:


From corner location found, and as described above,

New Bearing Tree, 11" L.P. Pine, bears N 50 1/2° E a distance of 240.8 feet, which I marked 1/4 S 17 BT.

New Bearing Tree, 16" L.P. Pine, bears S 35° W a distance of 246.7 feet, which I marked 1/4 S 20 BT.

Attached USFS signs 54-4 and 54-3 to all Bearing Trees, and painted blazes and a 6" wide band of florescent red around trunks. Attached brass tag, marked R.L.S. 1024, to new Bearing Trees.

Set 6' steel fence post 5' West of corner and attached USFS sign 54-4.

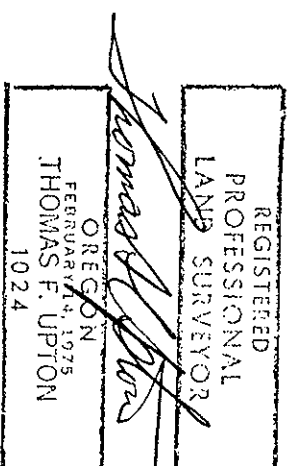

Thomas F. Upton, Certificate No. R.L.S. 1024

Office of DAVID S. WEAVER County of MORROW
 State of OREGON, I hereby certify that the within instrument was filed in this office
 for record on the 12th day of JANUARY, 1982
Deborah H. Krumbein by Jonathan A. Heister
 (COUNTY OFFICIAL) (DEPUTY)

Form R6-7100-57 (9/71)

RECEIVED BY
 Morrow County Surveyor
 Date January 12, 1982
 Rec'd By M. Heister
 No. 462-K
 Ref. drwg. NO. C-459-K