

RECORD OF LAND CORNER MONUMENTATION

NORTHWEST CORNER SECTIONS 21, T. 5 S., R. 28 E., W.M.


ORIGINALLY ESTABLISHED BY: Edward W. Sanderson, U.S. Deputy Surveyor

CONTRACT NUMBER: 417

CONTRACT DATE: August 24, 1881

SUBSEQUENT SURVEYS:

- ▶ 1938/1939 Dependant Resurvey by Leonard Carter, Public Land Surveyor for the General Land Office, under Group No. 228 approved May 2, 1938
- ▶ Remonumentation performed by Thomas F. Upton, PLS 1024, see corner certificate filed January 12, 1982 in the Morrow County Surveyor's records

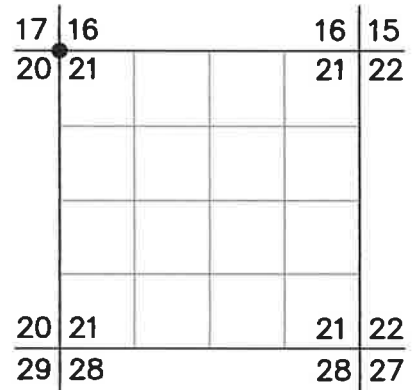

1881 GLO DESCRIPTION: Set a sandstone 18x10x4 ins 12 ins in ground for Cor. to Secs. 16, 17, 20 & 21 marked with 3 notches on S. and 4 notches on E. edges from which
 A Black Pine 6 in dia bears N.30°E 27 lks dist. marked T.5S. R.28E. Sec. 16 B.T.
 A Black Pine 8 in dia bears N.60°W 32 lks dist. marked T.5S. R.28E. Sec. 17 B.T.
 A Fir 9 in dia bears S.45°W 16 lks dist. marked T.5S. R.28E. Sec. 20 B.T.
 A Fir 12 in dia bears S.35°W 40 lks distant marked T.5S. R.28E. Sec. 21 B.T.

1938 GLO DESCRIPTION: Proportionate measurement, Set an iron post, 3 ft. long, 2 ins. diam., 28 ins. in the ground, for cor. of secs. 16, 17, 20, and 21, with brass cap mkd. (diagram shown) from which
 A white fir, 15 ins. diam., bears N.55°E., 80 lks. dist., mkd. T 5 S R 28 E S 16 B T.
 A white fir, 13 ins. diam., bears S.47°E., 46 lks. dist., mkd. T 5 S R 28 E S 21 B T.
 A white fir, 5 ins. diam., bears S.22°W., 18 lks. dist., mkd. T 5 S R 28 E S 20 B T.
 A white fir, 25 ins. diam., bears N.80°W., 26 lks. dist., mkd. T 5 S R 28 E S 17 B T.

UPTON'S DESCRIPTION: 2 inch iron pipe, with 2 1/2 inch brass cap marked as shown above, from which—
 26" White Fir, alive and standing, bears N 55° E (record), 52.8' (record), blaze healed, scar visible.
 20" White Fir, alive and standing, bears S 47° E (record), 30.5' (record 30.4'), blaze healed, scar visible.
 13" White Fir, alive and standing, bears S 22° W (record), 11.9' (record), blaze healed, scar visible.
 26" Fir, dead and standing, bears N 80° W (record), 17.6' (record 17.2'), scribing T5S R28E S17 BT legible.
 From corner location found, and as described above,
 New Bearing Tree, an 8" White Fir, bears N 48° W a distance of 17.2 feet, which I marked T5S R28E S17 BT

EVIDENCE FOUND: Found 2" iron pipe with attached 2 1/2" GLO brass cap (marked as shown below), projecting 10" above ground with no visible mound of stone. From which:
 A white fir snag, 23" dbh, 6 feet tall, bears N.55°E., 52.8 ft. with healed blaze
 The SW and NW bearing trees scribed in 1938 were found dead and down, as was the bearing tree scribed by Upton. No remains of the SE bearing tree scribed in 1938 could be found.

DESCRIPTION OF MONUMENTS AND ACCESSORIES SET AND METHODS USED:

I accept the found brass-capped monument for the true corner position.
 From which, I SCRIBE THE FOLLOWING NEW BEARING TREES:

- ▶ A western larch, 8" dbh bears N.11°E., 46.74 ft. marked "X" in upper blaze and "BT" in lower blaze
- ▶ A Douglas-fir, 11" dbh bears S.28°E., 9.58 ft. marked "T5SR28ES21" in upper blaze and "BT" in lower blaze
- ▶ A white fir, 12" dbh bears N.84°W., 27.4 ft. marked "X" in upper blaze and "BT" in lower blaze
- ▶ A western larch, 10" dbh bears N.25°W., 61.6 ft. marked "S17" in upper blaze and "BT" in lower blaze

Painted a 6 inch red band around the bearing trees, and also painted the blazes red. Attached USFS signs 54-3 and 54-9 to the bearing trees. Distances measured with a steel tape to a 60d nail driven in the side-center-right at the root crown of the new BTs. Bearings were measured with a magnetic compass with 14° East declination.

MONUMENT MARKED:



RESTORATION BY, STAMP AND DATE:

Work Performed September 29, 2021 by:

Jason L. Hatfield, PLS
 Reid Kelly

USDA FOREST SERVICE
 NORTHEAST OREGON LAND ZONE
 1550 Dewey Avenue, Suite A
 Baker City, OR 97814
 (541) 523-1337

RECEIVED BY
Morrow County Surveyor
 Date: 1-5-2022
 Rec'd By: MPK
 No.: SS28N9
 Folder No.: _____

