

CERTIFIED RECORD OF LAND CORNER MONUMENTATION

N-9

History of original corner establishment:

Corner originally established 1882 under Contract Survey No. 417, dated 1881.

Corner re-established by Dependent Resurvey authorized 1938 and approved Feb. 21, 1941.

DIAGRAM	
T55	R28E
17	16
20	21
1938	

Description of corner evidence found:


- 2 inch iron pipe, with 2 1/2 inch brass cap marked as shown above, from which---
- 26" White Fir, alive and standing, bears N 55° E (record), 52.8' (record), blaze healed, scar visible.
- 20" White Fir, alive and standing, bears S 47° E (record), 30.5' (record 30.4'), blaze healed, scar visible.
- 13" White Fir, alive and standing, bears S 22° W (record), 11.9' (record), blaze healed, scar visible.
- 26" fir, dead and standing, bears N 80° W (record) 17.6' (record 17.2'), scribbling T55 R28E S17 BT legible.

Description of monument and accessories | established to perpetuate the original location of this corner:

From Corner location found, and as described above,
New Bearing Tree, an 8" White Fir, bears N 48° W a distance of 17.2 feet, which I marked T55 R28E S17 BT.

Attached USFS signs 54-3 and 54-4 to all Bearing Trees, and painted blazes and a 6" wide band of fluorescent red around trunks. Attached brass tag, marked R.L.S. 1024, to new Bearing Tree.

Set 6' steel fence post 5' North of corner and attached USFS signs, 54-2 over 54-4.

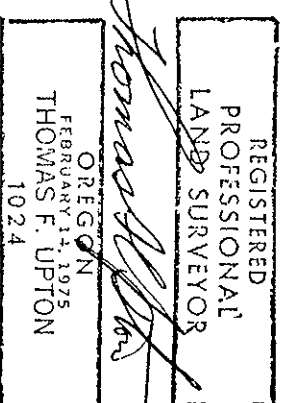

 REGISTERED PROFESSIONAL LAND SURVEYOR
 THOMAS F. UPTON
 OREGON
 1024

Thomas F. Upton, Certificate No. R.L.S. 1024

Office of... Co. Surveyor County of... Morrow
 State of... Oregon hereby certify that the within instrument was filed in this office
 for record on the 12th day of... January 1982
David H. Krumbein by Marta A. Hughes
 (COUNTY OFFICIAL) (DEPUTY)

Form R6-7100-57 (9/71)

RECEIVED BY ★ GPO—798-276
Morrow County Surveyor

Date January 12, 1982
 Rec'd By M. Hughes
 No. 4684

