

**CERTIFIED RECORD OF LAND CORNER MONUMENTATION**

Refer to: Plat of Penland 1988 Cadastral Survey  
Section 22, T.5S., R.28E., W.M.

0-15

History of original corner establishment:  
Donald L. Staebler, RPE 5408 set an iron pin during  
a survey in 1972.

**DIAGRAM**  
T5S R28E  
0  
N1/16|S22  
0

**Description of corner evidence found:**  
From the corner point:  
A 3/4" dia. Iron rod (rebar) bears N490E, 0.5 ft..

**Description of monument and accessories I established to perpetuate the original location of this corner:**  
At the corner point I set a 2 1/2" x 30" alum. pipe with a 2 1/2" alum. cap containing a magnet and marked:

Monument is 25" in the ground.  
From the corner:  
N1/16|S22  
0  
PLS 1832  
1988

A Lodgepole Pine, 12" dia., N23 3/4°W, 25.4 ft.;;  
marked; ONI/16 S22-BT  
A Lodgepole Pine, 8" dia., S60 1/4°W, 51.6 ft.;; marked; ONI/16 S22 BT  
BTs have blaze and a 6" band painted red; BT tags, "Land Survey Monument" signs and alum. "PLS 1832" washers nailed to the bottom of the blaze.  
There is a 6' steel fence-post with a "Land Survey Monument" sign within 5' of the corner.

Measured to center of BTs using steel tape and staff compass. Magnetic declination set at 18 3/40E.  
September 1, 1988


RECEIVED BY

Morrow County Surveyor

Date 11/28

Rec'd By JMK

No. D874K

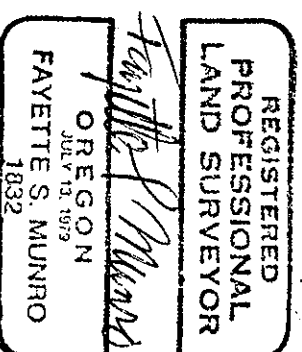

Office of..... County of.....

State of..... I hereby certify that the within instrument was filed in this office  
for record on the..... day of....., 19.....

..... by .....  
(COUNTY OFFICIAL) (DEPUTY)