

CERTIFIED RECORD OF LAND CORNER MONUMENTATION

P-10


History of original corner establishment:

The section in which this corner is located was originally surveyed under Contract Survey No. 417, dated 1881.

This section was later included in Dependent Resurvey authorized in 1938, and approved Feb. 21, 1941.

Note:

The corner identified by this record was not monumented in connection with either of the surveys noted above.

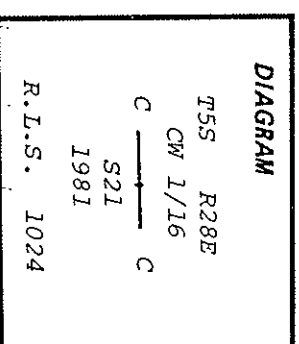

Description of corner evidence found:

Corner not previously monumented.

Description of monument and accessories | established to perpetuate the original location of this corner:

At the location of this corner, as established by a survey conducted by me, set a 2 1/2 inch alum. pipe, 30 inches long, 2 feet in the ground, with an alum. cap marked as shown above.

From the monument as set,

A Bearing Tree, a 10" L.P. Pine, bears N 59° W, a distance of 193.1 feet, which I scribed CW 1/16 S21 BT.

A reference monument, a 2 1/2 inch alum. pipe, bears S 58° W a distance of 47.64 feet, which I marked CW 1/16 S21 1981 RM R.L.S. 1024, with arrow pointing to corner.

Attached USFS signs, 54-3 and 54-9, and brass tag marked R.L.S. 1024, to Bearing Tree, painted blaze and a 6" wide band of fluorescent red around trunk.

Set 6' steel fence post 5' North of corner with USFS sign, 54-2 over 54-9.
Set 6' steel fence post at reference monument with USFS sign 54-9.

REGISTERED
PROFESSIONAL
LAND SURVEYOR

Thomas F. Upton

OREGON
FEBRUARY 14, 1975
THOMAS F. UPTON
1024

Thomas F. Upton, Certificate No. R.L.S. 1024

Office of... *Co. Surveyor* County of *Morrow*

State of... *Oregon* hereby certify that the within instrument was filed in this office
for record on the *12th* day of *January*, 1982
David H. Krimbaum by *Jantha A. Hughes*

(COUNTY OFFICIAL) (DEPUTY)

RECEIVED BY
Morrow County Surveyor

Jantha A. Hughes
the January 12, 1982
481-K