

CERTIFIED RECORD OF LAND CORNER MONUMENTATION

211


History of original corner establishment:

The Section in which this corner is located was originally surveyed under Contract Survey No. 417, dated 1881.

This Section was later included in Dependent Resurvey authorized in 1938 and approved Feb. 21, 1941.

Note:

The corner identified by this record was not monumented in connection with either of the Surveys noted above.

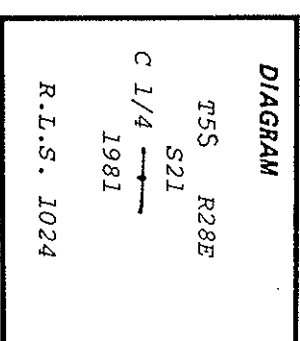

Description of corner evidence found:

Corner not previously monumented.

Description of monument and accessories | established to perpetuate the original location of this corner:

At the location of this corner, as established by a survey conducted by me, set a 2 1/2 inch alum. pipe, 30 inches long, 2 feet in the ground, with an alum. cap marked as shown above. From this monument as set,

A Bearing Tree, a 10" White Fir, bears N 28° E a distance of 9.0 feet, which I marked C 1/4 S21 BT.

A Bearing Tree, a 21" Spruce, bears N 40° W a distance of 45.7 feet, which I marked C 1/4 S21 BT.

Attached USFS signs 54-3 and 54-9, and a brass tag, marked R.L.S. 1024, to all trees, and painted blazes and a 6" band of fluorescent red around trunks.

Set 6' steel fence post 5' North of corner with USFS sign 54-9.

REGISTERED
PROFESSIONAL
LAND SURVEYOR

Thomas F. Upton

OREGON
FEBRUARY 14, 1975
THOMAS F. UPTON
1924

Thomas F. Upton, Certificate No. R.L.S. 1024

Office of Co. Surveyor County of Morrow

State of Oregon hereby certify that the within instrument was filed in this office
for record on the 12th day of January, 1982

David H. Krumbein Deborah A. Blugher
(COUNTY OFFICIAL) (DEPUTY)

Form R6-7100-57 (9/71)

RECEIVED BY ☆ GPO-798-276

Morrow County Surveyor

Date January 12, 1982

Rec'd By M. Blugher

No. 416-K

Ref. Drawg. No. C-460-K