


RECORD OF LAND CORNER MONUMENTATION

CENTER-EAST 1/16 CORNER SECTION 21, T. 5 S., R. 28 E., W.M.

ORIGINALLY ESTABLISHED BY: Thomas F. Upton, PLS 1024

COUNTY SURVEYOR DOCUMENTATION: Map of Survey recorded 1/12/82 as C-460-K-465 and associated monumentation record filed 1/12/82

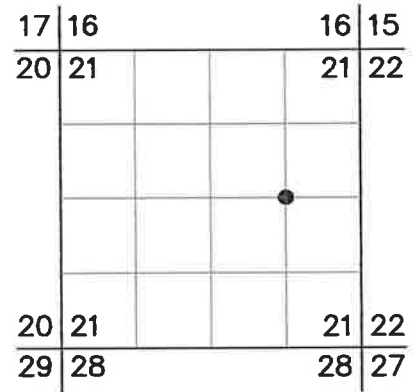

ORIGINAL DESCRIPTION: At the location of this corner, as established by a survey conducted by me, set a 2 1/2 inch alum. pipe, 30 inches long, 2 feet in the ground, with an alum. cap marked as shown above.

From the monument as set,

- A Bearing Tree, an 11" White Fir, bears N 29° E, a distance of 22.4 feet, which I marked CE 1/16 S21 BT
- A Bearing Tree, an 11" White Fir, bears S 5° W a distance of 22.4 feet, which I marked CE 1/16 S21 BT

EVIDENCE FOUND: Found a 2 1/2" aluminum pipe with 2 3/4" aluminum cap projecting 4" above ground with no visible mound of stone. From which, I found the following bearing trees:

- ▶ A white fir, dead and down, bears N.29°E. with scribing visible in an open double blaze
- ▶ A white fir stump, cut 6 ft. high, bears S.5°W., 22.4 ft. with scribing visible in an open double blaze


DESCRIPTION OF MONUMENTS AND ACCESSORIES SET AND METHODS USED:
I accept the found aluminum monument for the true corner position.

From which, I SCRIBE THE FOLLOWING NEW BEARING TREE:

- ▶ A western larch, 10" dbh bears S39°E., 20.64 ft. marked "CE1/16 S21" in upper blaze, and "BT" in lower blaze

I also SET THE FOLLOWING REFERENCE POINT:

- ▶ A 5/8"x30" iron pin driven flush with the ground bears N.66°E., 5.73 ft., with attached 2" aluminum cap marked "RP 1 2021 PLS 69454"

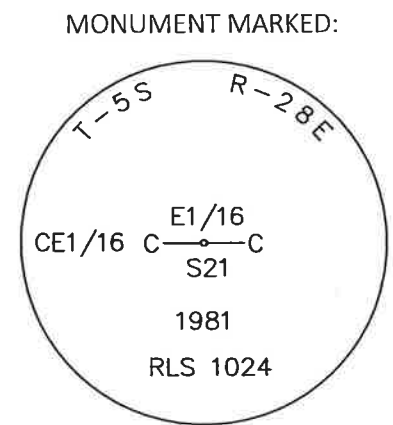

Painted a 6 inch red band around the bearing trees, and also painted the blazes red, and attached USFS signs 54-3 and 54-9. Distances measured with a steel tape. Distance to new bearing tree was measured to a 60d nail driven in the side-center-right at the root crown of the tree. Bearings were measured with a magnetic compass with 14° East declination.

RESTORATION BY, STAMP AND DATE:

Work Performed October 5, 2021 by:

Jason L. Hatfield, PLS

USDA FOREST SERVICE
NORTHEAST OREGON LAND ZONE
1550 Dewey Avenue, Suite A
Baker City, OR 97814
(541) 523-1337

RECEIVED BY
Morrow County Surveyor

Date: 1-5-2022
Rec'd By: MPK
No.: SS28P12
Folder No.: _____

