


CERTIFIED RECORD OF LAND CORNER MONUMENTATION

P-12

History of original corner establishment:

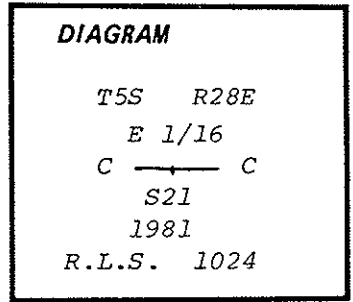

The section in which this corner is located was originally surveyed under Contract Survey No. 417, dated 1881.

This section was later included in Dependent Resurvey authorized in 1938 and approved Feb. 21, 1941.

Note:

The corner identified by this record was not monumented in connection with either of the surveys noted above.

Description of corner evidence found:

Corner not previously monumented.

Description of monument and accessories I established to perpetuate the original location of this corner:

At the location of this corner, as established by a survey conducted by me, set a 2 1/2 inch alum. pipe, 30 inches long, 2 feet in the ground, with an alum. cap marked as shown above.

From the monument as set,

A Bearing Tree, an 11" White Fir, bears N 29° E, a distance of 22.4 feet, which I marked CE 1/16 S21 BT.

A Bearing Tree, an 11" White Fir, bears S 5° W, a distance of 22.4 feet, which I marked CE 1/16 S21 BT.

Attached USFS signs, 54-3 and 54-9, and a brass tag marked R.L.S. 1024 to all trees. Painted blazes and a 6" wide band of florescent red around trunks.

Set a steel fence post 6' long, 5' North of corner and attached USFS signs, 54-2 over 54-9.

REGISTERED PROFESSIONAL LAND SURVEYOR

Thomas F. Upton

OREGON FEBRUARY 14, 1975 THOMAS F. UPTON 1024
--

Thomas F. Upton, Certificate No. R.L.S. 1024

Office of Co. Surveyor..... County of Morrow.....
 State of Oregon..... I hereby certify that the within instrument was filed in this office
 for record on the 12th day of January....., 1982
David H. Krumbein..... by Martha A. Hughes.....
 (COUNTY OFFICIAL) (DEPUTY)

RECEIVED BY

☆ GPO—798-276

Morrow County Surveyor
 Date January 12, 1982
 Rec'd By M. Hughes
 No. 482-K
 Ref. orw. no. C-460-K