


CERTIFIED RECORD OF LAND CORNER MONUMENTATION

P-13

History of original corner establishment:

Corner originally established 1882 under Contract Survey No. 417, dated 1881.
Corner re-established by Dependent Resurvey authorized 1938 and approved Feb. 21, 1941.

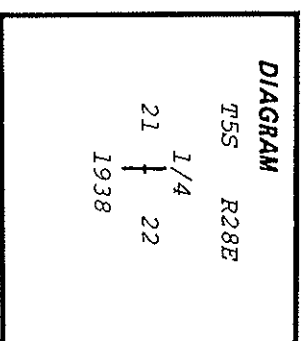

Description of corner evidence found:

1 inch iron pipe with 2 1/2 inch brass cap, marked as shown above, from which---
13" Fir, alive and standing, bears N 29° E (record), 24.9' (record 25.7'), blaze healed, scar visible.
26" Fir, dead and standing, bears N 73 1/2° W (record N 72° W), 54.2' (record 54.1'), scribing 1/4 S21 BT legible.

Description of monument and accessories | established to perpetuate the original location of this corner:

From Corner location as found and described above,
A new Bearing Tree, a 12" White Fir, bears N 12 1/2° W a distance of 34.2 feet, which I marked 1/4 S21 BT.
Attached USFS signs 54-3 and 54-4 to all Bearing Trees, and a brass tag, marked R.L.S. 1024, to new Bearing Tree. Painted blazes and a 6" wide band of fluorescent red around trunks of all trees.
Set a 6' steel fence post 5' North of corner and attached USFS sign 54-4.

REGISTERED
PROFESSIONAL
LAND SURVEYOR

Thomas F. Upton

OREGON
FEBRUARY 14, 1975
THOMAS F. UPTON
1024

Thomas F. Upton, Certificate No. R.L.S. 1024

Office of... Co. Surveyor County of... Morrow
State of... Oregon hereby certify that the within instrument was filed in this office
for record on the 12th day of... January 1982
by David H. Krumbein Maatha A. Hughes
(COUNTY OFFICIAL) (DEPUTY)

Form R6-7100-57 (9/71)

RECEIVED BY
Morrow County Surveyor
Date January 12, 1982
Rec'd By M. Hughes
No. 475-K
Ret. dwg. no. C-460 K