


CERTIFIED RECORD OF LAND CORNER MONUMENTATION

Refer to: Plat of Penland 1988 Cadastral Survey
 Section 22, T.5S., R.28E., W.M.

History of original corner establishment:
 None.

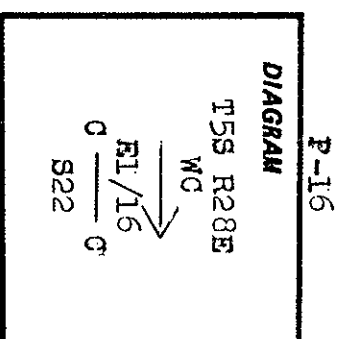

Description of corner evidence found:
 None.

Description of monument and accessories | established to perpetuate the original location of this corner:

I set a 2 1/2" x 30" alum. pipe with a 2 1/2" alum. cap containing a magnet and marked:

Monument is S89° 03' 12"W, 23.06 ft. from C-E1/16 corner, which falls below the high water line of Penland Lake.

WC →
 E1/16
 0 ——— 0
 S22
 PLS 1832
 1988

Monument is 22" in the ground and surrounded by a mound of stone.

From the monument:

A White Fir, 12" dia., S74 1/2°W, 20.6 ft.; marked X at breast height and BT at base.

A Lodgepole Pine, 10" dia., N25°W, 19.3 ft.; marked X at breast height and BT at base.

BTs have blaze and a 6" band painted red, BT tags, "Land Survey Monument" signs and alum. "PLS 1832" washers nailed to the bottom of the blaze. There is a 6' steel fence-post with a "Land Survey Monument" sign within 5' of the monument.

Measured to center of BTs using steel tape and staff compass. Magnetic declination set at 18 1/2°E.

September 1, 1988

RECEIVED BY

Morrow County Surveyor

Date 11/28

Rec'd By COHLK

No. D874K

Office of..... County of.....
 State of..... I hereby certify that the within instrument was filed in this office
 for record on the..... day of....., 19.....

(COUNTY OFFICIAL) by..... (DEPUTY)

**REGISTERED
 PROFESSIONAL
 LAND SURVEYOR**

OREGON
 JULY 13, 1979
FAYETTE S. MUNRO
 1832