


CERTIFIED RECORD OF LAND CORNER MONUMENTATION

Refer to: Plat of Penland 1988 Cadastral Survey
Section 22, T.58., R.28E., W.M.

History of original corner establishment:
None.

P-16

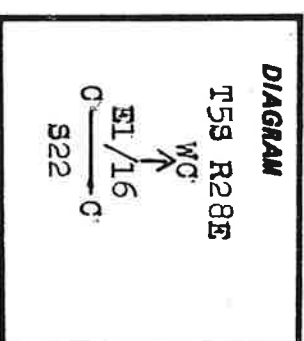


Description of corner evidence found:
None.

Description of monument and accessories I established to perpetuate the original location of this corner:

I set a 2 1/2" x 30" alum. pipe with a 2 1/2" alum. cap containing a magnet and marked;

Monument is 80° 26' 55"W, 951.47 ft. from C-E1/16 corner, which falls below the high water line of Penland Lake.

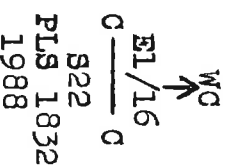

Monument is 25" in the ground.

From the monument:

A Spruce, 8" dia., S14°W, 39.8 ft.; marked X at breast height and BT at base.

A Spruce, 1 1/2" dia., S49°W, 33.0 ft.; marked X at breast height and BT at base.

BTs have blaze and a 6" band painted red, BT tags, "Land Survey Monument" signs and alum. "PLS 1832" washers nailed to the bottom of the blaze. There is a 6' steel fence-post with a "Land Survey Monument" sign within 5' of the monument.

Measured to center of BTs using steel tape and staff compass. Magnetic declination set at 18°E.

September 1, 1988

REGISTERED
 PROFESSIONAL
 LAND SURVEYOR

Timothy J. Munro

OREGON
 JULY 13, 1979
 FAYETTE S. MUNRO
 1832

 State of Or. I hereby certify that the within instrument was filed in this office
 for record on the 1 day of Nov., 1988
David H. R. Lee (COUNTY OFFICIAL) by

RECEIVED BY

Form R6-7100-57 (9/71)

Morrow County Surveyor

GPO-798-576

Date 11/88
 Rec'd By COHK
 No. D8741C