


**CERTIFIED RECORD OF LAND CORNER MONUMENTATION**

**History of original corner establishment:**

E.W. Sanderson under G.L.O. contract no. 417, dated Aug. 24, 1881, set a post 3' square, 3' long, 24" in the ground. From corner:  
 A Black pine, 10" dia., S50°W, 19 lks.  
 A Fir, 8" dia., S10°W, 21 lks.  
 Leonard Carter, Public Land Surveyor, under G.L.O. special instructions, Group No. 228, dated Mar. 23, 1938; found the original post and replaced it with a 1"x 36" iron post with a brass cap marked:  
 From the corner:

A White Fir, 20" dia., S60°E, 21 lks.; with healed blaze.  
 (Old BT)  
 A Tamarack, 28" dia., S23°W, 22 lks. (New BT)

S22|S23  
 1938

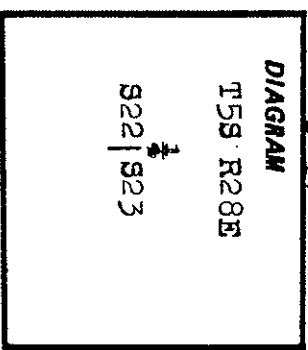

**Description of corner evidence found:**  
 I found a 1" iron pipe with a 2 1/2" brass cap (G.L.O.) marked: S22|S23  
 From the corner: 1938

A Western Larch stump, 30" dia.; S23°W, 14.5 ft.; with a healed blaze.  
 A White Fir, 32" dia., S60°E, 13.9 ft.; with a healed blaze.

**Description of monument and accessories I established to perpetuate the**

**original location of this corner:**  
 I built a mound of stone around the monument and marked a new BT:

A White Fir, 18" dia., S49 3/4°W, 35.1 ft.; marked: 1/4 S22 BT

BTs have blaze and a 6" band painted red, BT tags and "Land Survey Monument" signs. New BT has, additionally, an alum. "PLS 1832" washer nailed to the bottom of the blaze. There is a 6' steel fence post with a "Land Survey Monument" sign within 5' of the corner.

Measured to center of BTs using steel tape and staff compass. Magnetic declination set at 18 1/2°E.

September 2, 1988

RECEIVED BY  
 Morrow County Surveyor

Date 11/28  
 Rec'd By DAWK  
 No. D 874K

REGISTERED  
 PROFESSIONAL  
 LAND SURVEYOR  
 OREGON  
 JULY 13, 1979  
 FAYETTE S. MUNRO  
 1832

Office of....., County of.....  
 State of....., I hereby certify that the within instrument was filed in this office  
 for record on the..... day of....., 19.....

..... by .....  
 (COUNTY OFFICIAL) (DEPUTY)