


CERTIFIED RECORD OF LAND CORNER MONUMENTATION

P-18

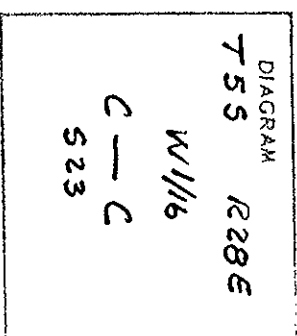

History of original corner establishment:
Insurveyed - subdivided section.

To record of subsequent remonumentation found in County Records.

Description of corner evidence found:
No evidence found.

I set the monument described below midway between the found W 1/4 and the computed center of Section 23.

Description of monument and accessories I established to perpetuate the original location of this corner

At the position described above, I set a 2 1/2" x 30" iron pipe 22" in ground with a brass cap marked as shown:

From which I scribed BTs:

A fir 10" in diam. bears N 70° W 16.4' marked C W 1/16 S 23 BT.
A tamarack 13" in diam. bears S 16° W 17.5' marked C W 1/16 S 23 BT.

I nailed a brass washer marked PLS 1638 to the BT blazes.


I set a steel fence post West 5' with signs 54-2 & 4.

I painted a red band around BTs and face of scribe.

I used a steel tape and a magnetic compass with 20° East variation and measured a horizontal distance to the center of BTs.

This corner set September 4, 1979. Witness by Dennis L. Paasch.

See map of survey.

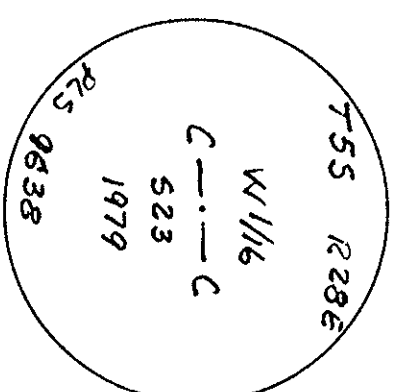

Office of County Surveyor County of Morrow
State of Oregon, I hereby certify that the within instrument was filed in this office
for record on the 7th day of September
David A. Kober (COUNTY OFFICIAL) by (DEPUTY)

REGISTERED
PROFESSIONAL
LAND SURVEYOR
Terry E. Hamby
OREGON
JULY 14, 1978
TERRY E. HAMBY
1638

Form R6-7100-57 (9/71)

RECEIVED BY
Morrow County Surveyor
Date 9-7-79
Rec'd By TMAJ
No. #252-K
Corresponding drawings