


CERTIFIED RECORD OF LAND CORNER MONUMENTATION

P-19

History of original corner establishment:

Unsurveyed - subdivided section.

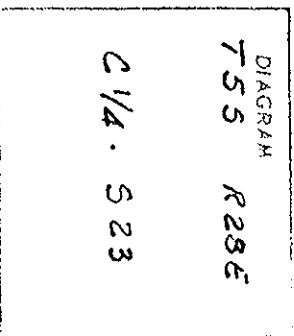

No record of subsequent remonumentation found in County Records.

Description of corner evidence found:

No evidence found.

I set the monument described below at the point of intersection of the four found $\frac{1}{4}$ s of Section 23.

Description of monument and accessories I established to perpetuate the original location of this corner

At the position described above, I set a $2\frac{1}{4}$ " x 30" Iron pipe 24" in ground with a brass cap marked as shown:

From which I scribed BIs:

A lodgepole pine 15" in diam, bears N 13° W 149.9' marked C $\frac{1}{4}$ S 23 T 55 R 29E RT
A fir 15" in diam, bears S 66° E 170.9' marked C $\frac{1}{4}$ S 23 T 55 R 29E RT

I nailed a brass washer marked PLS 1639 to the BI blaze.


I set a steel post 35' North and 5" East with signs 54-2 & 4.

I painted a red band around BIs and painted face of scribe.

This corner set September 5, 1979. Witness by W. Keith Sands.

See map of survey.

I used a steel tape and magnetic compass with 20" East variation and measured a horizontal distance to the center of the BIs.

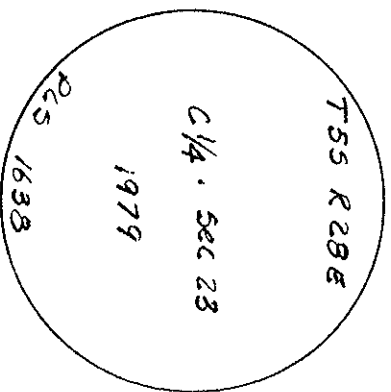

Office of County Surveyor County of Morrow
State of Oregon I hereby certify that the within instrument was filed in this office
for record on the 7th day of September
David H. Kales by (DEPUTY)
(COUNTY OFFICIAL)

PROFESSIONAL
LAND SURVEYOR
TERRY E. HAMBY
OREGON
JULY 14, 1978
1638

RECEIVED BY

Form R6-7100-57 (9/71)

Morrow County Surveyor

Date 9-7-79

Rec'd By MRL

No. #252-K

Corresponding drawing