


CERTIFIED RECORD OF LAND CORNER MONUMENTATION

P-20

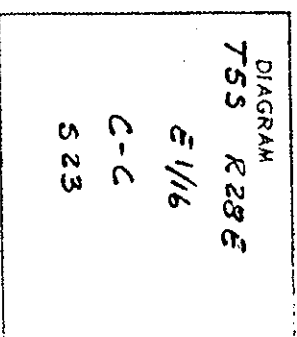

History of original corner establishment:
 Insurveyed - subdivided section.

To record of subsequent remonumentation found in County Records.

Description of corner evidence found:
 No evidence found.

I set the monument described below midway between
 the found E 1/4 and the computed center of Section 23.

Description of monument and accessories I established to perpetuate the
 original location of this corner

At the position described above, I set a 2 1/2" x 30" iron pipe 22" in
 ground with a brass cap marked as shown:

From which I scribed BIs:

A tamarack 1 1/2" in diam. bears S 73° E 28.7' marked C E 1/16 S 23 BI
 A tamarack 10" in diam. bears S 17° W 68.0' marked C E 1/16 S 23 BI

I nailed a brass washer marked PLS 1638 to the BI blaze.


I set a steel fence post 6' West and 25' South with signs 54-2 & 4.

I painted a red band around BIs and painted face of scribe.

I used a steel tape and magnetic compass with 20° East
 variation and measured a horizontal distance to the
 center of BIs.

This corner set September 5, 1979. Witness by W. Keith Sands.

See map of survey.

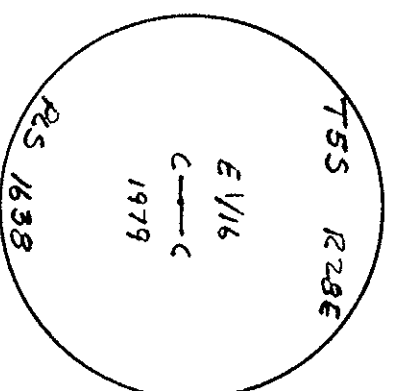

Office of County Surveyor Morrow County of Morrow
 State of Oregon, I hereby certify that the within instrument was filed in this office
 for record on the 7th day of September by David H. Hamby
 (COUNTY OFFICIAL) (DEPUTY)

REGISTERED
 PROFESSIONAL
 LAND SURVEYOR

Terry E. Hamby
 OREGON
 JULY 14, 1978
 TERRY E. HAMBY
 No. 1638

RECEIVED BY

Morrow County Surveyor

Date 9-7-79

Rec'd By MLJ

No. # 252-K

corresponding drawing

Form R6-7100-57 (9/71)

252-K