


CERTIFIED RECORD OF LAND CORNER MONUMENTATION

Q-20

History of original corner establishment:

Insurveyed - subdivided section.

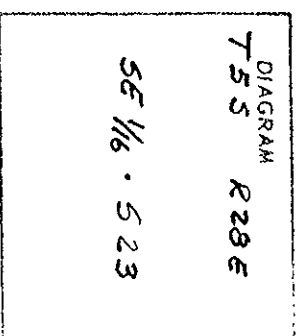

No record of subsequent remonumentation found in County Records.

Description of corner evidence found:

No evidence found.

I set the monument described below at the point of intersection four opposite 1/16 corners.

Description of monument and accessories I established to perpetuate the original location of this corner

At the position described above, I set a 2 1/4" x 30" iron pipe 22" in ground with a brass cap marked as shown:

From which I scribed BTs:

A lodgepole pine 1 1/2" in diam. bears N 33° E 94.7' marked SE 1/16 S 23 BT.


I nailed a brass washer marked PLS 1638 to the BT blaze.

I set a steel fence post 5' North and 5' East with signs 54-2 & 4.

I used a steel tape and magnetic compass with 20° East variation and measured a horizontal distance to the center of BTs.

This corner set September 4, 1979. Witness by Dennis L. Paasch.

See map of survey.

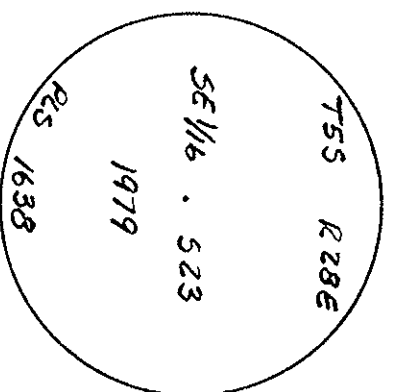

Office of County Surveyor Morrow
State of Oregon, I hereby certify that the within instrument was filed in this office for record on the 7th day of September by (DEPUTY)

David H. Keller (COUNTY OFFICIAL)

Bong E. Hamby (DEPUTY)

RECORDED
INDEXED
JULY 14, 1978
TERRY E. HAMBY
1638

RECEIVED BY

Morrow County Surveyor

Date 9-7-79

Rec'd By [Signature]

No. #258-K

#258-K